


DATE _____

TOWN OF LEXINGTON — BOARD OF PUBLIC WORKS

SEWER DIVISION

Sketch of Service Here

5

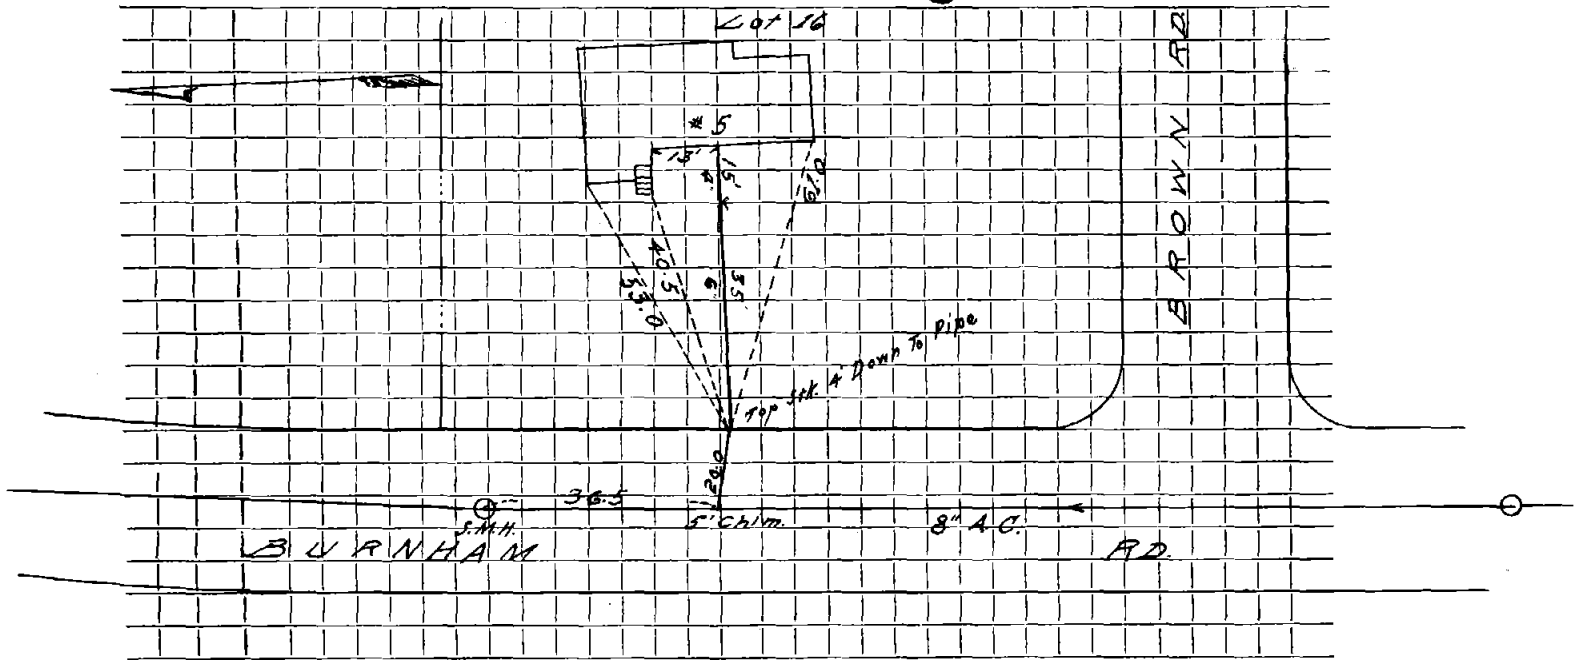

Connection made in Street. Work completed

Remarks: THIS HOUSE HAS TWO SEPARATE SEWER SERVICES


.....
.....

DATE OCT 31, 1984

TOWN OF LEXINGTON — BOARD OF PUBLIC WORKS
SEWER DIVISION

Sketch of Service Here

5

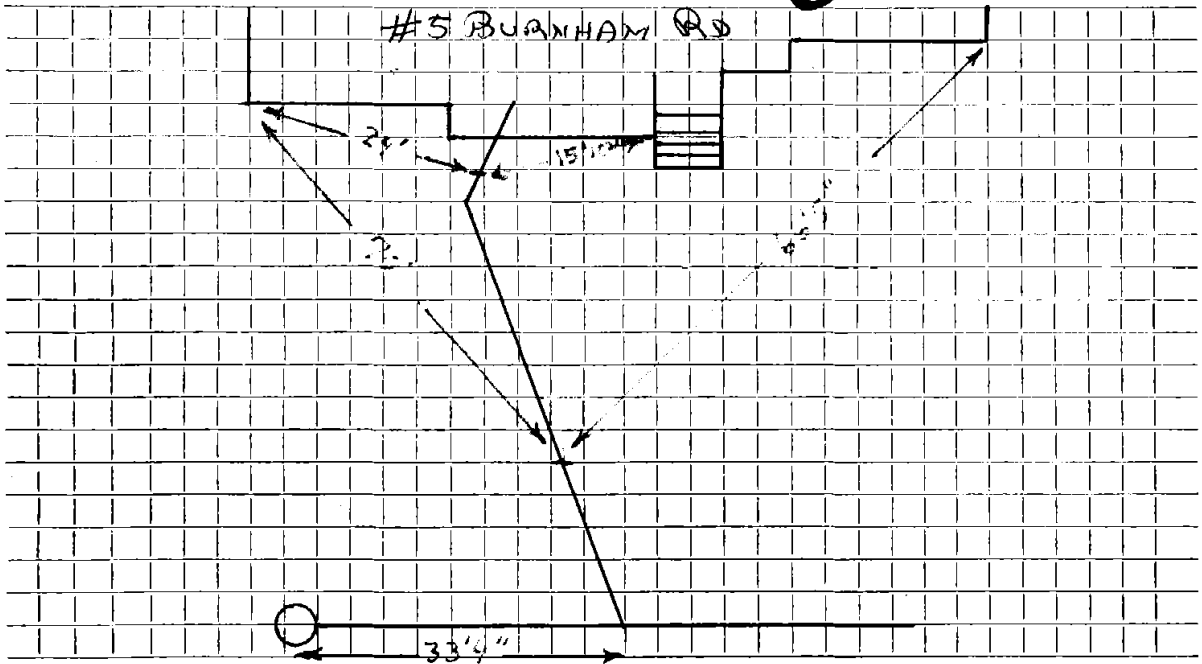

Connection made in BURNHAM RD Street. Work completed OCT 31, 1984.

Remarks: THIS HOUSE HAS TWO SEPERATE SEWER SERVICES