

Name Henry Wein

Service No. 117

Address 6 Burnham Road

Location

Kind of Pipe

Size

Size of Main

Repair—Renewal—New Service Aldo #805

Location Comm 10-30-67

Date	Material	Amount	Total	Date	Amount
------	----------	--------	-------	------	--------

Oct. 167	20'	6" Transite pipe @6.00			
---------------------	----------------	-----------------------------------	--	--	--

120.00

9/18/67

Deposit

120.00

10-10-67	30'	6" Transite pipe			
----------	-----	------------------	--	--	--

	10'	4" Cast Iron pipe			
--	-----	-------------------	--	--	--

10- - 67

20' 6" Transite


DATE _____

TOWN OF LEXINGTON — BOARD OF PUBLIC WORKS

SEWER DIVISION

Sketch of Service Here

6

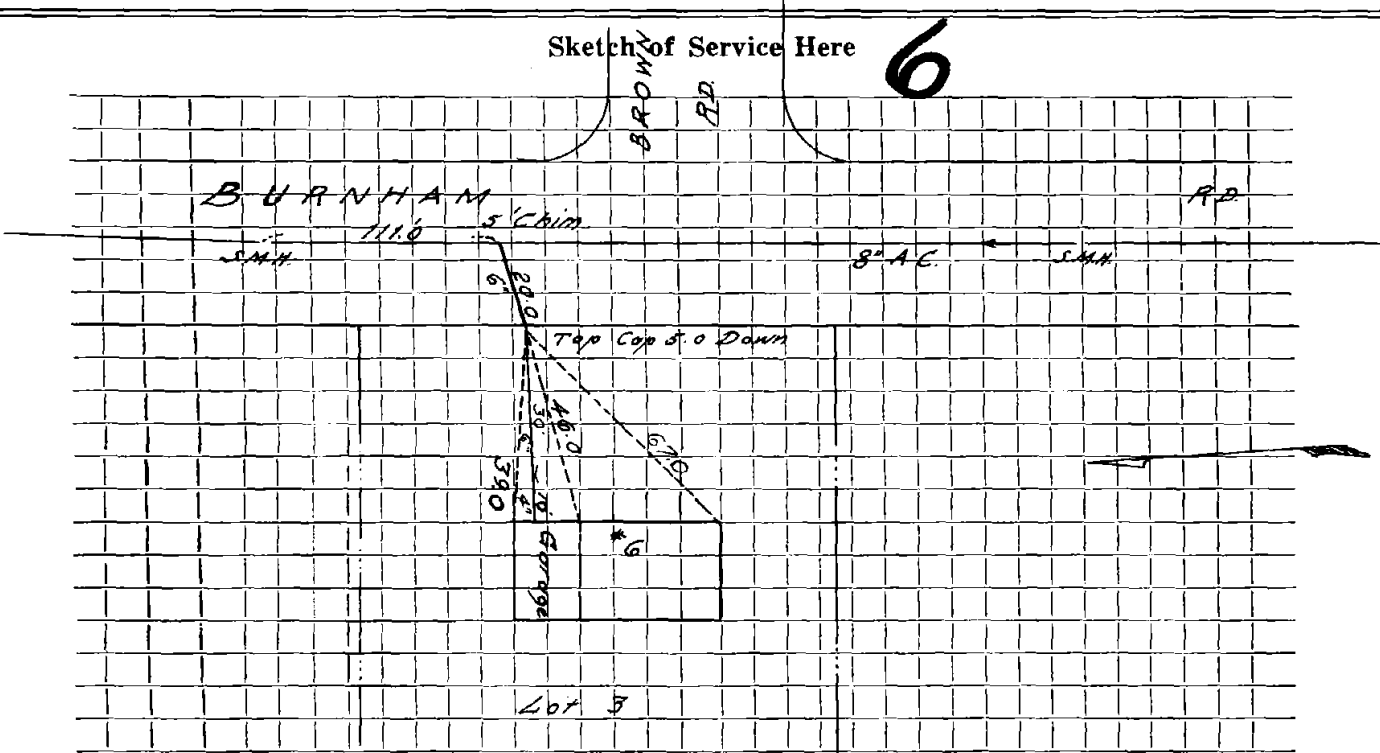

Connection made in Street. Work completed

Remarks:
.....
.....