


DATE 6/12/00

TOWN OF LEXINGTON — BOARD OF PUBLIC WORKS
SEWER DIVISION

Sketch of Service Here

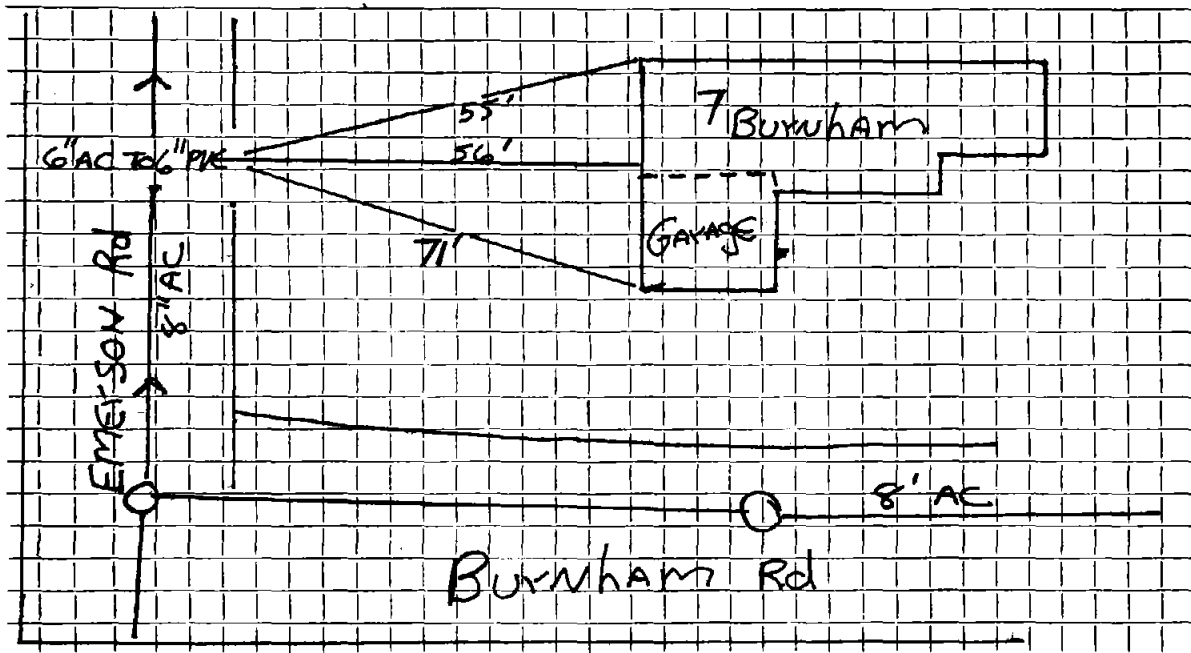

Connection made in Street. Work completed

Remarks: 7' DEEP AT 6x6 FURCO

.....
.....