

Name

Service No.

Address

8 Burnham Rd

Location

Kind of Pipe

SDR 35

Size

6" PVC

Size of Main

Repair—Renewal—New Service

Location

Date

Material

Amount

Total

Date

Amount


FERRY 5.5'  
cleanout 6"  
6" SDR

DATE \_\_\_\_\_

# TOWN OF LEXINGTON — BOARD OF PUBLIC WORKS

## SEWER DIVISION

Sketch of Service Here

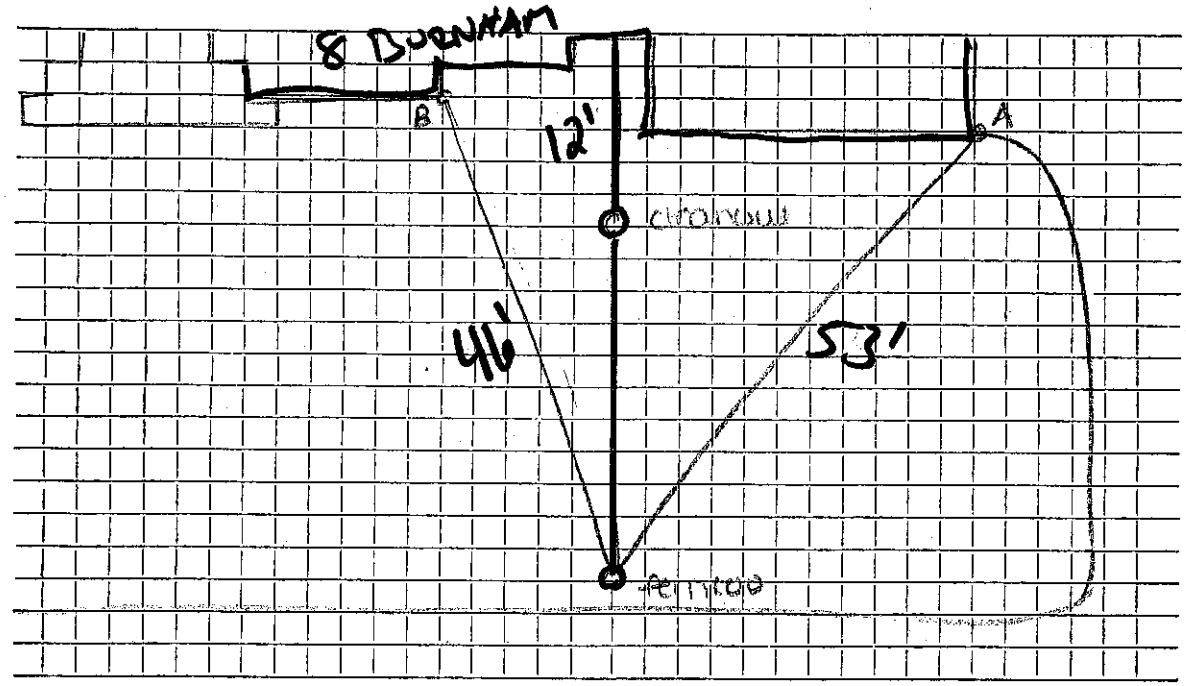

Connection made in ... Burnham Rd ... Street. Work completed .....

Remarks: .....  
.....  
.....