

Name Richard M. Masters

Service No. 122

Address 1 Burns Road

Location

JUN 18 1973

Kind of Pipe

Size

Size of Main

~~Repair/Removal~~ New Service

Valeri #2149

Location


| Date | Material | Amount | Total | Date | Amount |
|--------------------|-------------------------------------------------------------------------------|--------|-------------------|-------------------|-------------------|
| 5-19-65 | 42' 6" Transite pipe @5.00 | | 210.00 | 9-7-72 | 210.00 |
| | Repair Service W.O. #892 | | | 5-19-65 | Deposit |
| 11-26-79 | Labor | | | 42' 6" Transite | Je |
| | 2 5' Transite Nipple | | | | |
| | 1 15" Rough Nipple | | | | |
| | 1 6" Sleeve Adapter | | | | |
| | 2 ton Gravel | | | | |
| | 2 1/2 hrs. Trucking | | | | |
| | 2 hrs. Town Shovel | | | | |
| | 1/2 hr. Roller | | | | |
| | 4' x 15' Hot Top | | | 11-23-79 | Root's 95' out |
| 12-8-80 | 4' 6" A.C. pipe | | | | |
| | 1 Manhole Frame & Cover | | | | |
| | 1 Transite Adapter A.C. | | | | |
| | Replaced clay pipe under garage floor with 4" Iron pipe (Valeri Const. #3558) | | | | |

DATE _____

TOWN OF LEXINGTON — BOARD OF PUBLIC WORKS

SEWER DIVISION

Sketch of Service Here

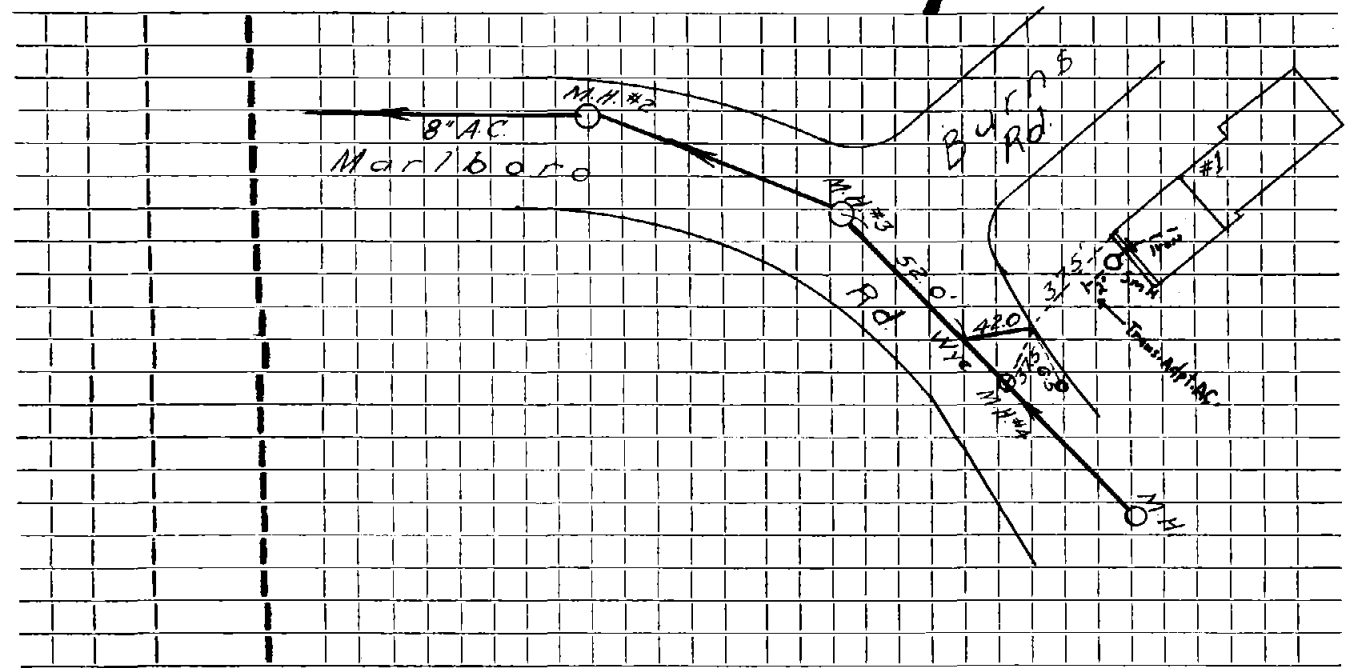

Connection made in Street. Work completed

Remarks: *Replaced Clay Pipe under garage floor with iron pipe.*

.....

.....