

Name FRANK TRANELLA  
 Address 10 BURROUGHS RD

Service No.  
 PERMIT # 1530

Location

Kind of Pipe


Size

Size of Main

Repair—Renewal—New Service


Location

Date	Material	Amount	Total	Date	OUTSIDE	Amount
5-23 01	INSIDE			9	68	32' 6" TRANSITE
	1-4X6" FERRO					
	10' 4" PVC					
	119' 6" PVC					
	2-6" PVC CLEANOUTS					

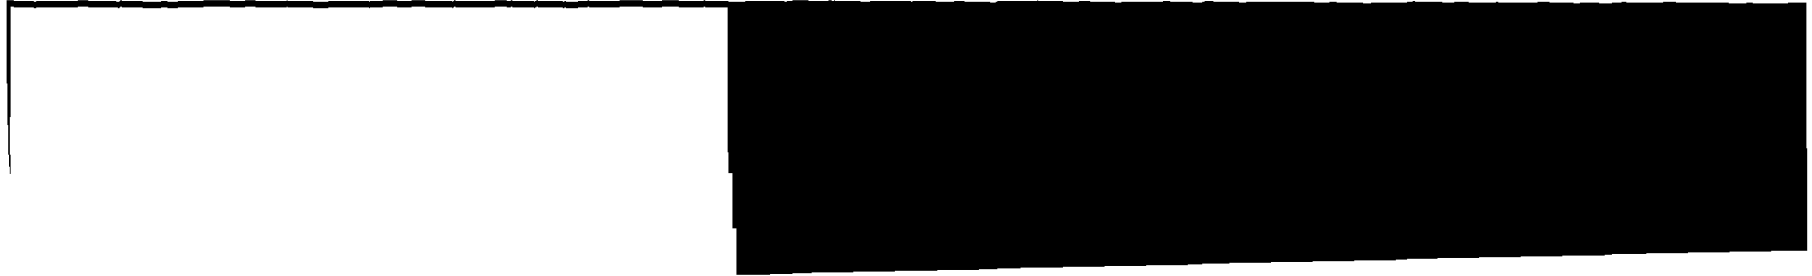

DATE 9-25-2001

TOWN OF LEXINGTON — BOARD OF PUBLIC WORKS  
SEWER DIVISION

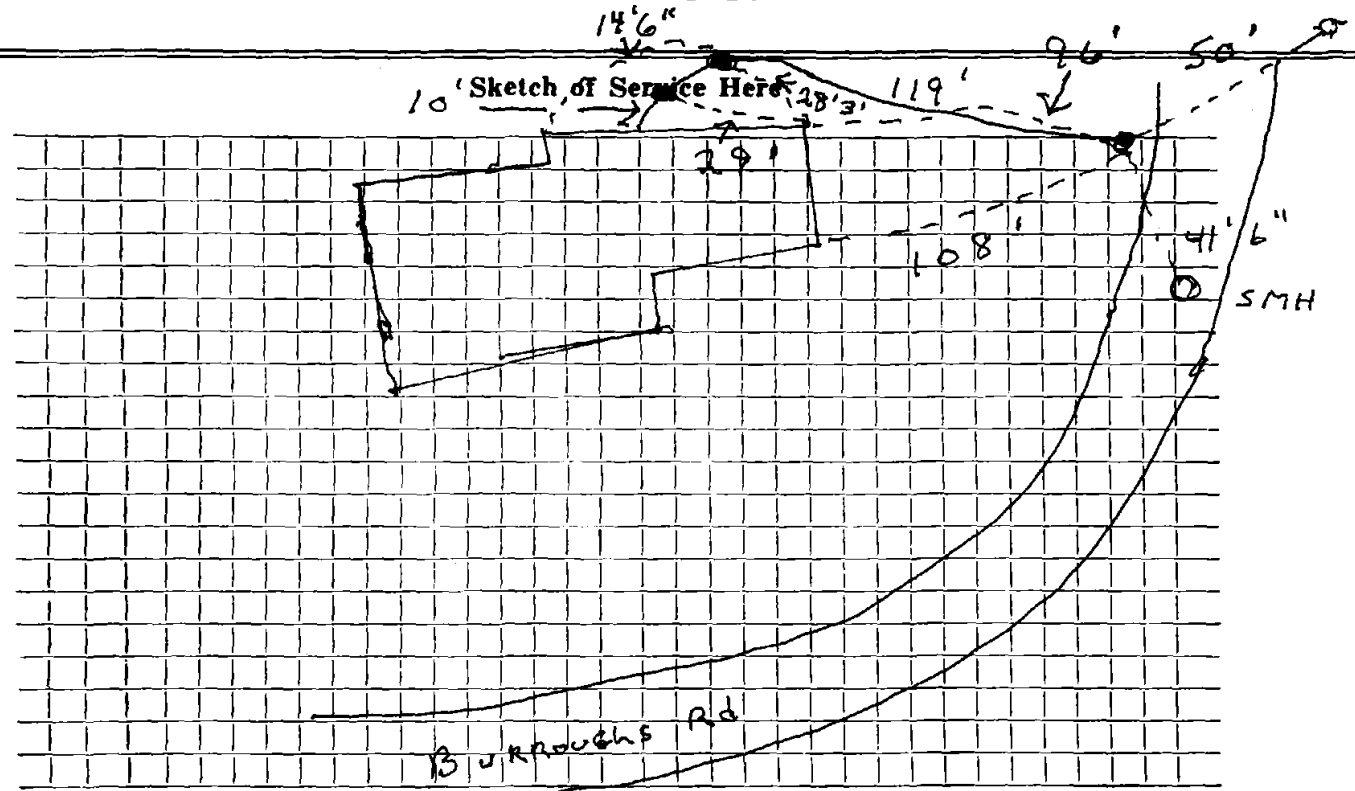

Connection made in BURROUGHS Rd Street. Work completed .....

Remarks: J. MC LAUGHLIN .....

