


DATE ~~14-3-4-67~~ ~~11/11~~

TOWN OF LEXINGTON — BOARD OF PUBLIC WORKS
SEWER DIVISION

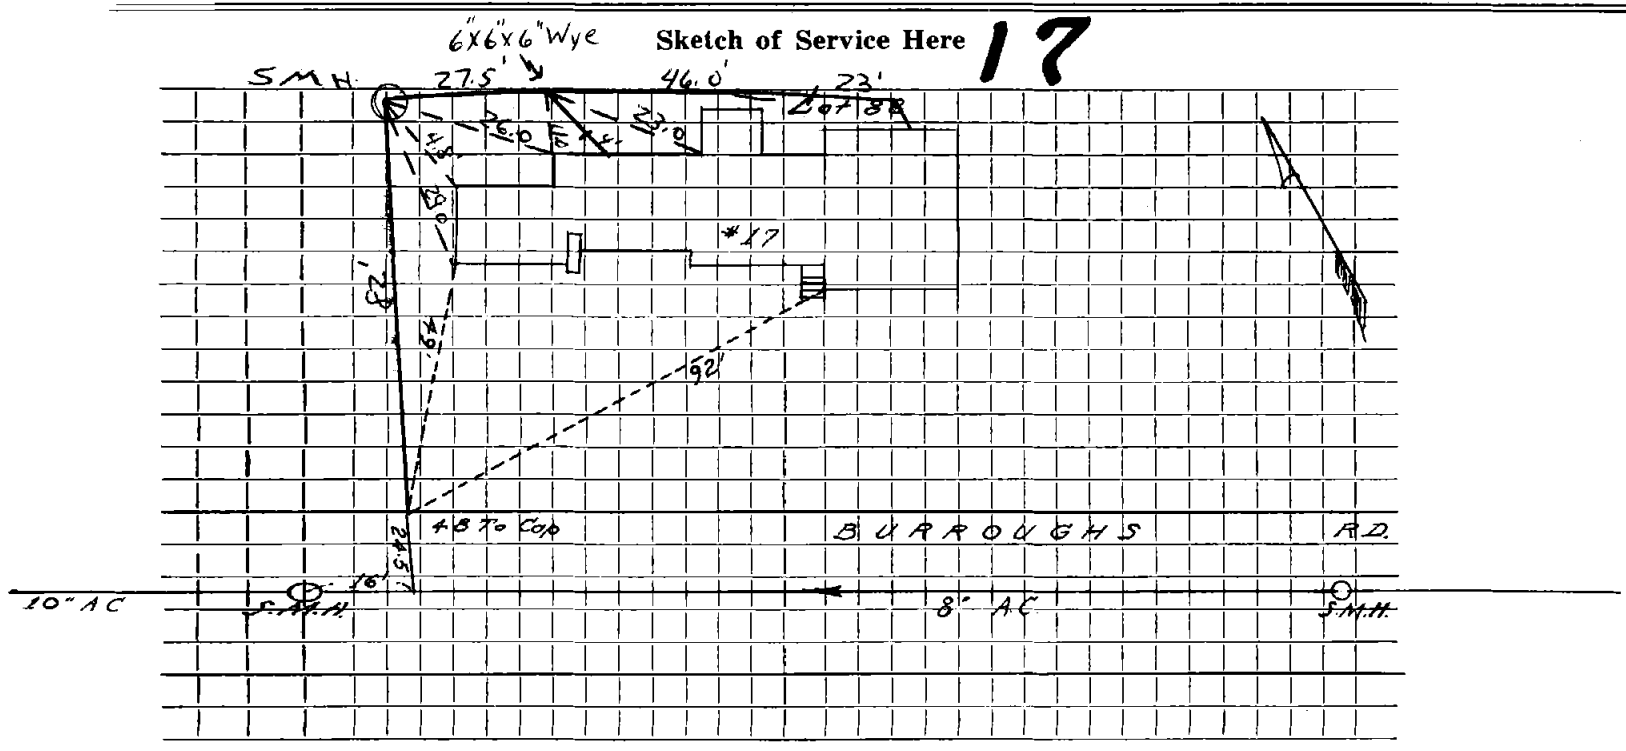

Connection made in Street. Work completed

Remarks: ..
.....
.....