

Name James Raffi

Service No. 16

Address 18 Burroughs Road

Lot 75

Location

Kind of Pipe

Size

Size of Main

Repair—Renewal—New Service

Kirkland & Shaw #1321

Location JUL 7 1969


Date	Material	Amount	Total	Date	Amount
Sep 1-68 28 1/2'	6" Transite pipe @ 8.00		228.00	4-28-69	Deposit 228.00
5-1-69	40' 6" Transite pipe				
	13' 4" Cast Iron pipe			9- -68	28.6
					6" Transite

DATE _____

TOWN OF LEXINGTON — BOARD OF PUBLIC WORKS
SEWER DIVISION

Sketch of Service Here

18

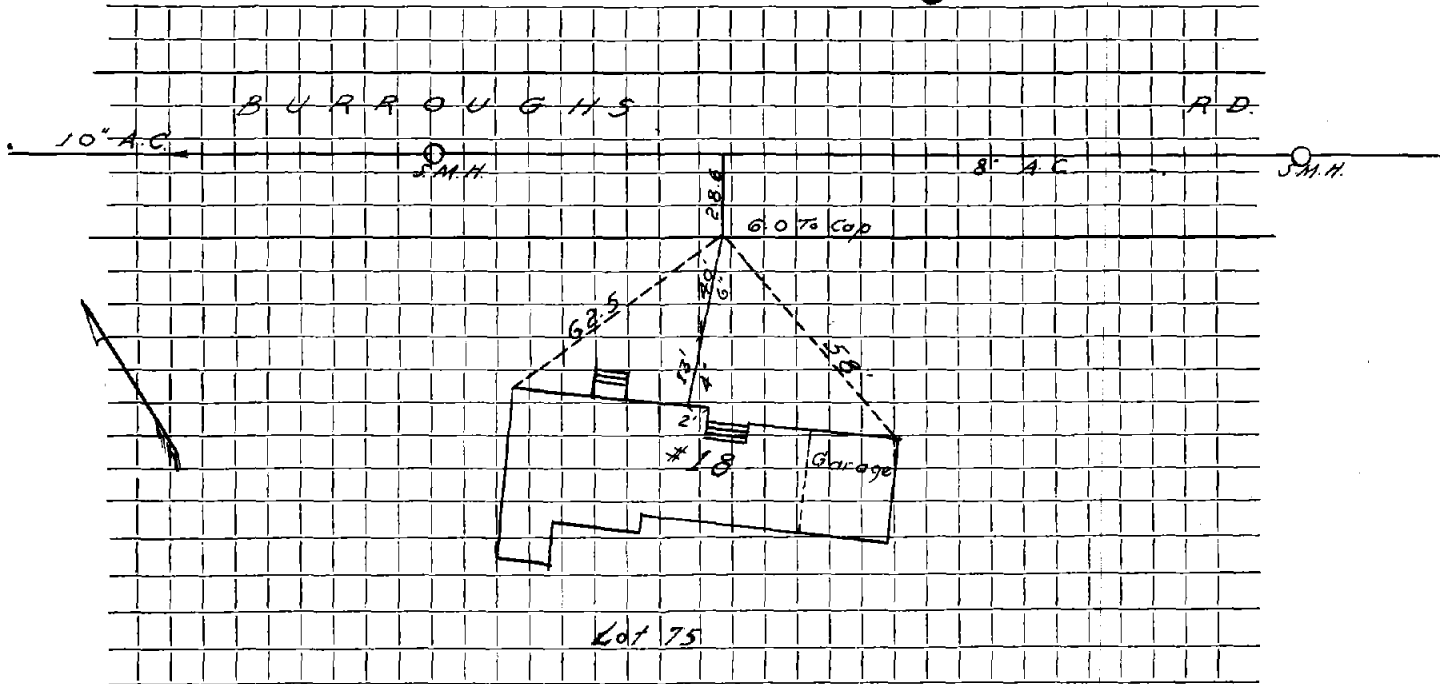

Connection made in Street. Work completed

Remarks:
.....
.....