

Name Seymour Handman

Service No. 48

Address 23 Burroughs Road  
Lot 85

Location

Kind of Pipe

Size

Size of Main

Repair—Renewal—New Service Valeri #2042

Location JUN 5 1972

Date	Material	Amount	Total	Date	Amount
<del>Sep 68</del>	<del>21 1/2' 6" Transite pipe @8.00</del>	<del>196.00</del>	<del>196.00</del>	<del>4-22-72</del>	<del>196.00</del>
5-1-72	52' 6" Transite pipe			9- -68	
	10' 4" Cast Iron pipe			24.6	6" Transite


DATE \_\_\_\_\_

TOWN OF LEXINGTON — BOARD OF PUBLIC WORKS

SEWER DIVISION

Sketch of Service Here

23

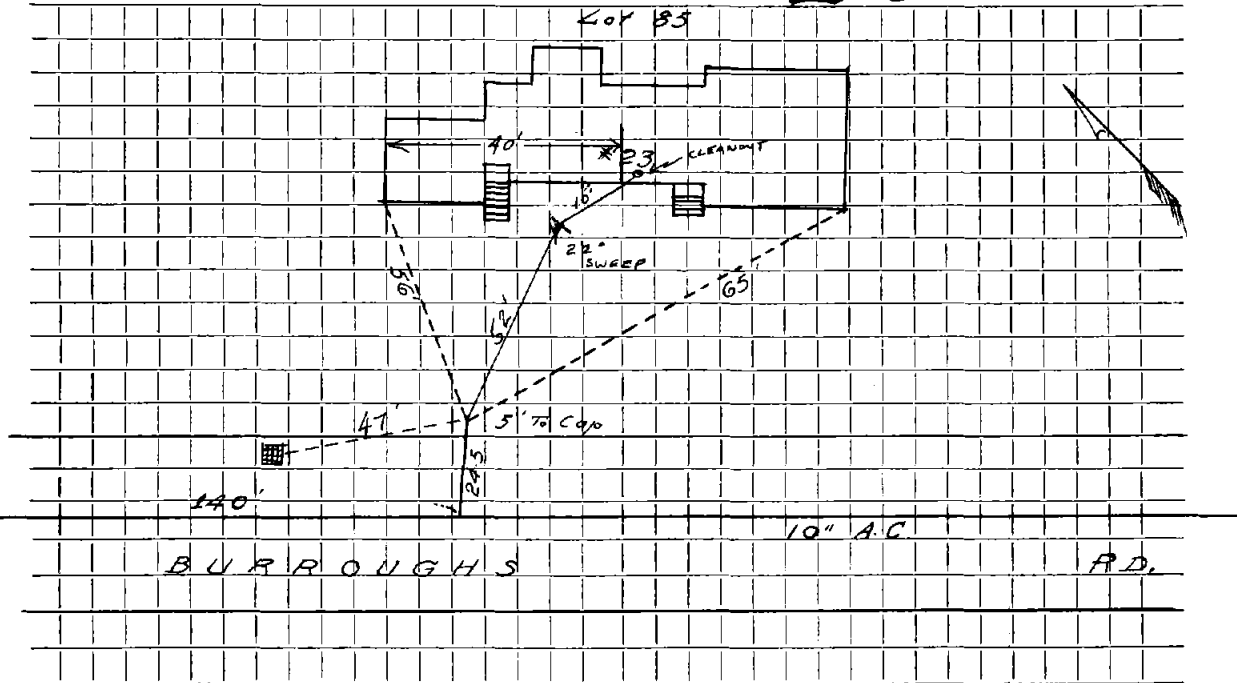

Connection made in ..... Street. Work completed .....

Remarks: .....

.....

.....