

Name Howard R. Anderson Service No. 24

Address 24 Burroughs Road Location _____

Lot 78

Kind of Pipe _____ Size _____ Size of Main _____

Repair—Renewal—New Service Suburbanite #1573 Location JUL 27 1970

Date	Material	Amount	Total	Date	Amount
Sep '68	302' 6" Transite pipe	28.00	244.00	5-5-70	244.00
5-11-70	70' 6" Transite pipe				
	55' 4" Cast Iron pipe			9- -68	
				30.6' 6" Transide	


DATE _____

TOWN OF LEXINGTON — BOARD OF PUBLIC WORKS

SEWER DIVISION

Sketch of Service Here

24

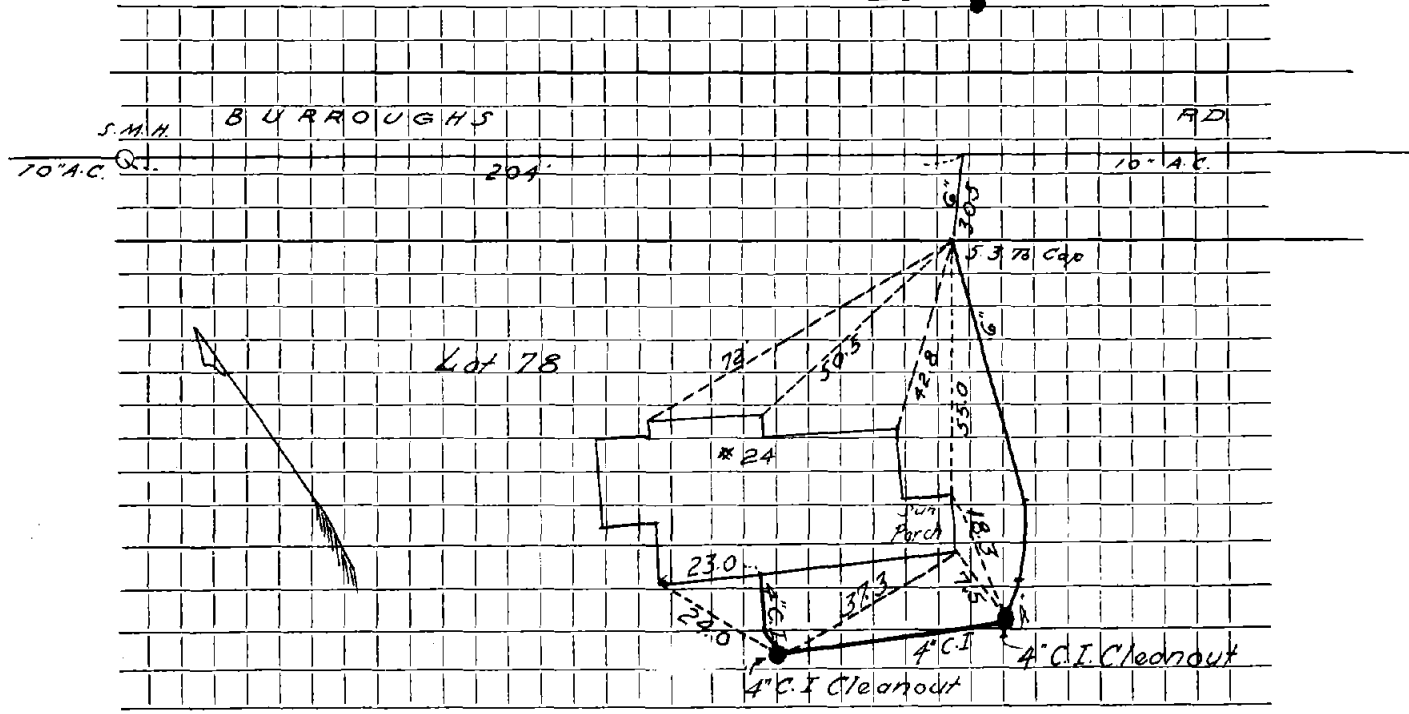

Connection made in Street. Work completed

Remarks:

.....

.....