

Name Dr. Barry Puchkoff

Service No. 41

Address 25 Burroughs Road
Lot 84

JUN 18 1973

Location

Kind of Pipe

Size

Size of Main

~~Repair/ Renewal~~ **New Service** Valeri Construction #2315


Location

Date	Material	Amount	Total	Date	Amount
Sep-68	22' 6" Transite pipe	@8.00	176.00	5-9-73	176.00
5-17-73	180' 6" transite				
	23' 4" cast iron			9- - 68	
				22' 6" Transite	
				12-31-73	S.B. Prince & Sons

DATE _____

TOWN OF LEXINGTON — BOARD OF PUBLIC WORKS

SEWER DIVISION

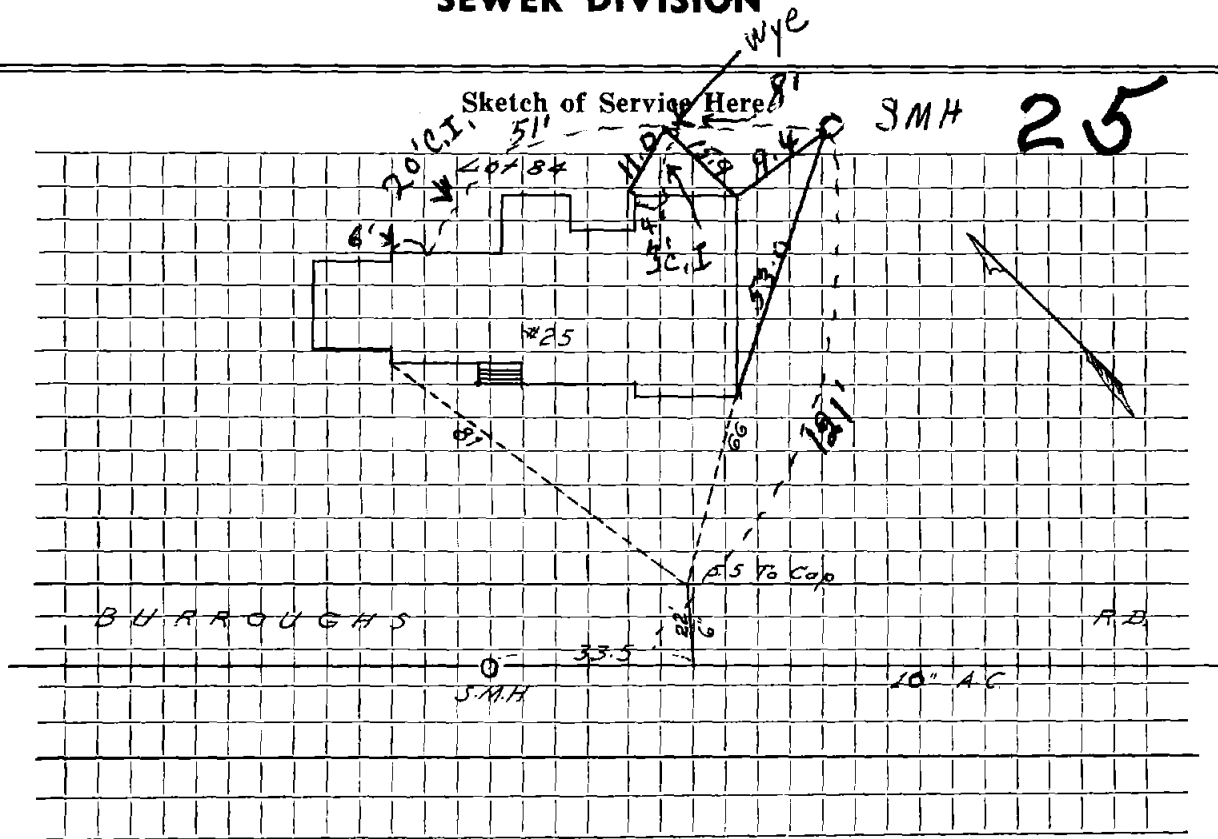

Connection made in Street. Work completed

Remarks:

.....

.....