

Name

Service No.

Address

26 Burrenghis

Location

Kind of Pipe

SDR 35

Size

6" PVC

Size of Main

Repair—Renewal—New Service

Location

Date	Material	Amount	Total	Date	Amount
8/15	6" SDR				
"	6' CLEAN OUT	1			
	6" PVC CAP				
	6" SDR RISER				
	6' TIE W/0				
"	6" 45° DENO	2			
	6" 22° DEN	2			
	6" x 6" FURNOU	1			
	ALSO PVC				


8/25/15

DATE

TOWN OF LEXINGTON — BOARD OF PUBLIC WORKS

SEWER DIVISION

Sketch of Service Here

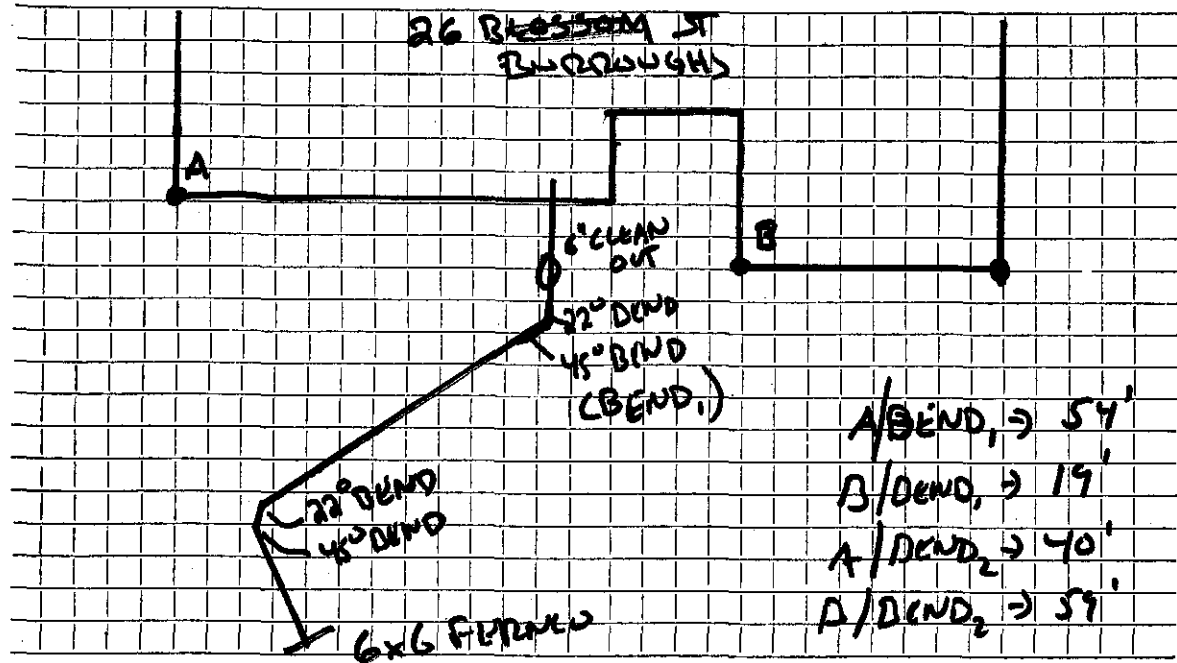

A/BEND₁ → 54'
 B/DEND₁ → 19'
 A/DEND₂ → 40'
 B/DEND₂ → 59'
 A/FERN → 52'
 B/FERN → 66'

BURROUGHS

Street.

Work completed FINNISAN

Connection made in ... Street. Work completed ...

Remarks:

.....

.....