

Name David Cohen Service No. 109
 Address 27 Burroughs Road

Lot 83 Location

Kind of Pipe Size Size of Main
~~Repair/ Renewal~~ - New Service Valeri #3956 Location JAN 21 1980

Date	Material	Amount	Total	Date	Amount
Sep '68 18'	6" Transite pipe	28.00	114.00	12-12-79	144.00
12/14/79	147'	6" Transite pipe			
	7'	4" Cast Iron pipe		9 - - 68	
				18' 6" Transite	


DATE _____

TOWN OF LEXINGTON — BOARD OF PUBLIC WORKS

SEWER DIVISION

Sketch of Service Here

27

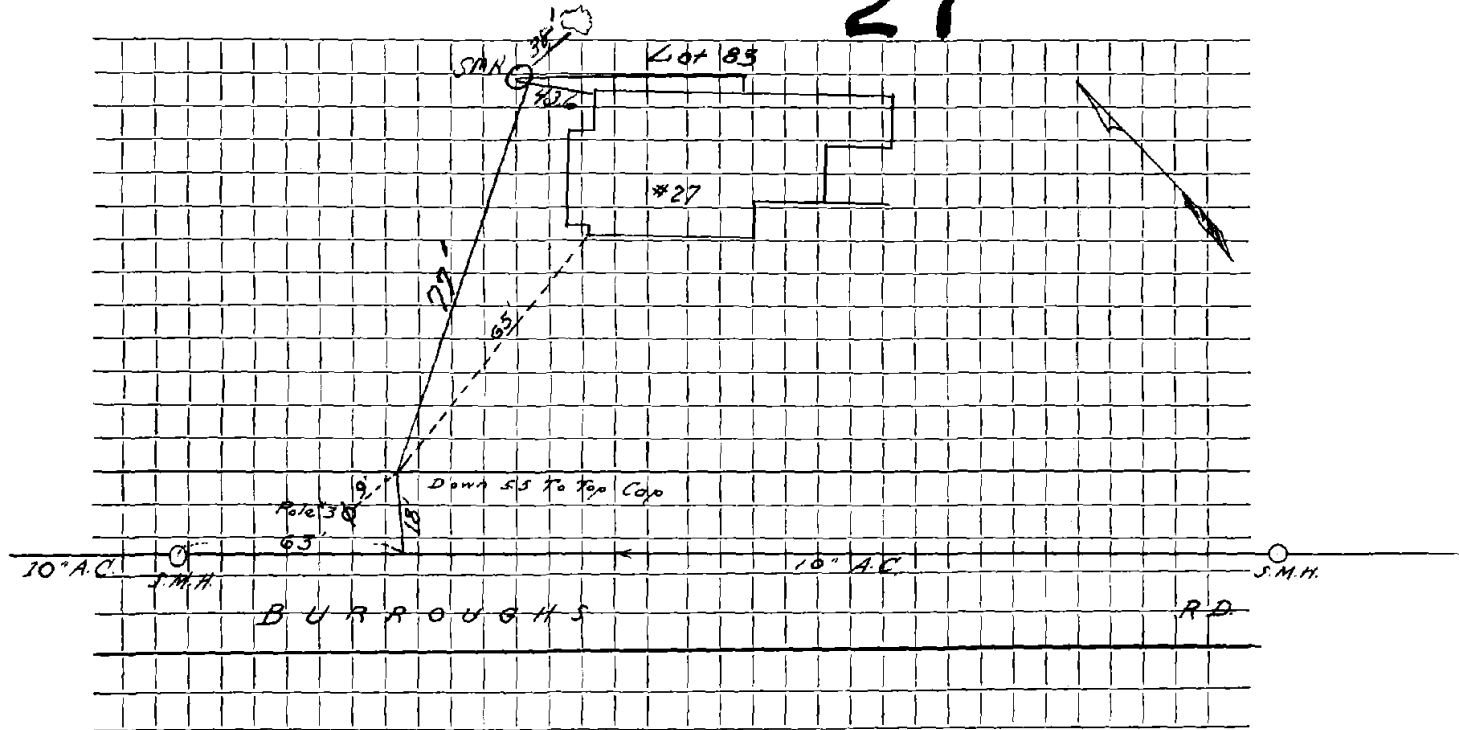

Connection made in Street. Work completed

Remarks:

.....

.....