


DATE 9-25-2001

TOWN OF LEXINGTON — BOARD OF PUBLIC WORKS

SEWER DIVISION

Sketch of Service Here

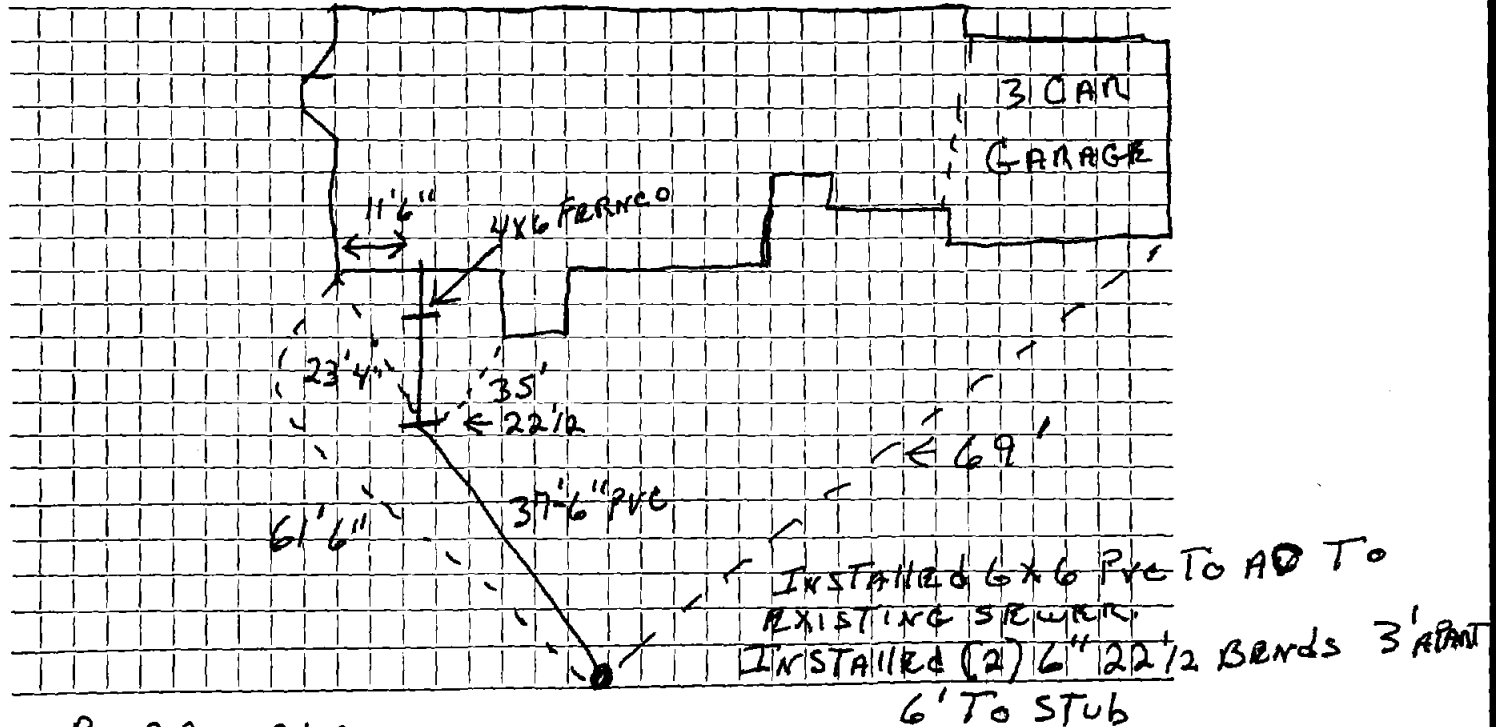

Connection made in ... BURROUGHS ... Street. Work completed

Remarks: ... J. McLaughlin ... INSTALLER