

Name

Service No.

Address 5 Burroughs Road

Lot 93

Location

Kind of Pipe

Size

Size of Main

Repair—Renewal—New Service DAUE DELIA


Location

Date	Material	Amount	Total	Date	Amount
Sep '68	22 1/2' 6" Transite pipe	@8.00	180.00		
4/13/77	48' 6" PVC			9- -68	
	1 ACTO PVC FERRO			22' 6" Transite	
	4" PVC				
	1 4" x 6" FERRO				

DATE _____

TOWN OF LEXINGTON — BOARD OF PUBLIC WORKS

SEWER DIVISION

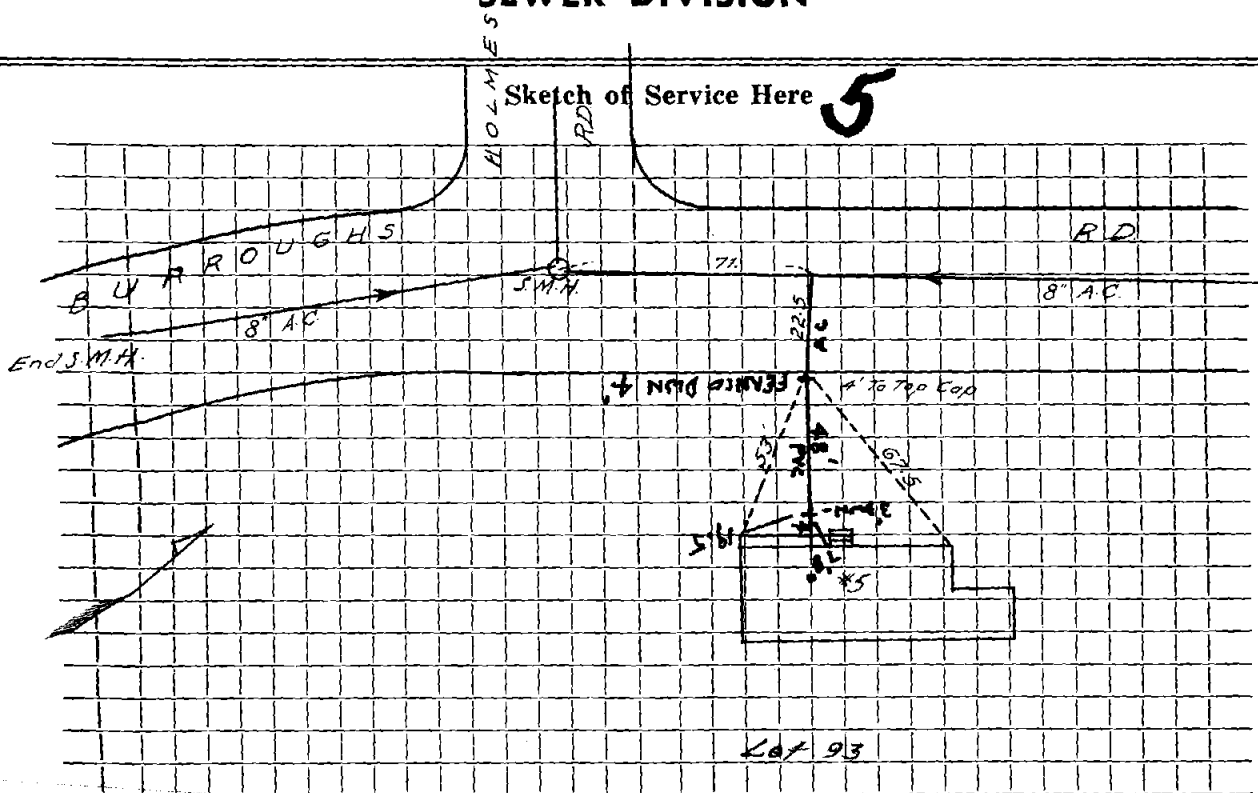

Connection made in Street. Work completed

Remarks:

.....

.....