

Name John Cusolito

Service No. 126

Address 7 Burroughs Road

Lot 92

Location

Kind of Pipe

Size

Size of Main

Repair—Renewal—New Service Vincent Sweeney #1504

Location MAR 30 1970


Date		Material	Amount	Total	Date		Amount
Sen '68	221	<del>6" Transite Pipe</del>	<del>@8.00</del>	180.00	10-29-69	Deposit	180.00
11-3-69	35'	6" Transite pipe					
	10'	4" Cast Iron pipe			6- - 68		
		Repair #4347 Valeri			226	6" Transite	
9/22/86	35'	6" PVC					
	1	4 x 6 CI x PVC Fernco					
	1	6 x 6 PVC x AC Fernco					

HOLMES RD

DATE \_\_\_\_\_

TOWN OF LEXINGTON — BOARD OF PUBLIC WORKS  
SEWER DIVISION

Sketch of Service Here **7**

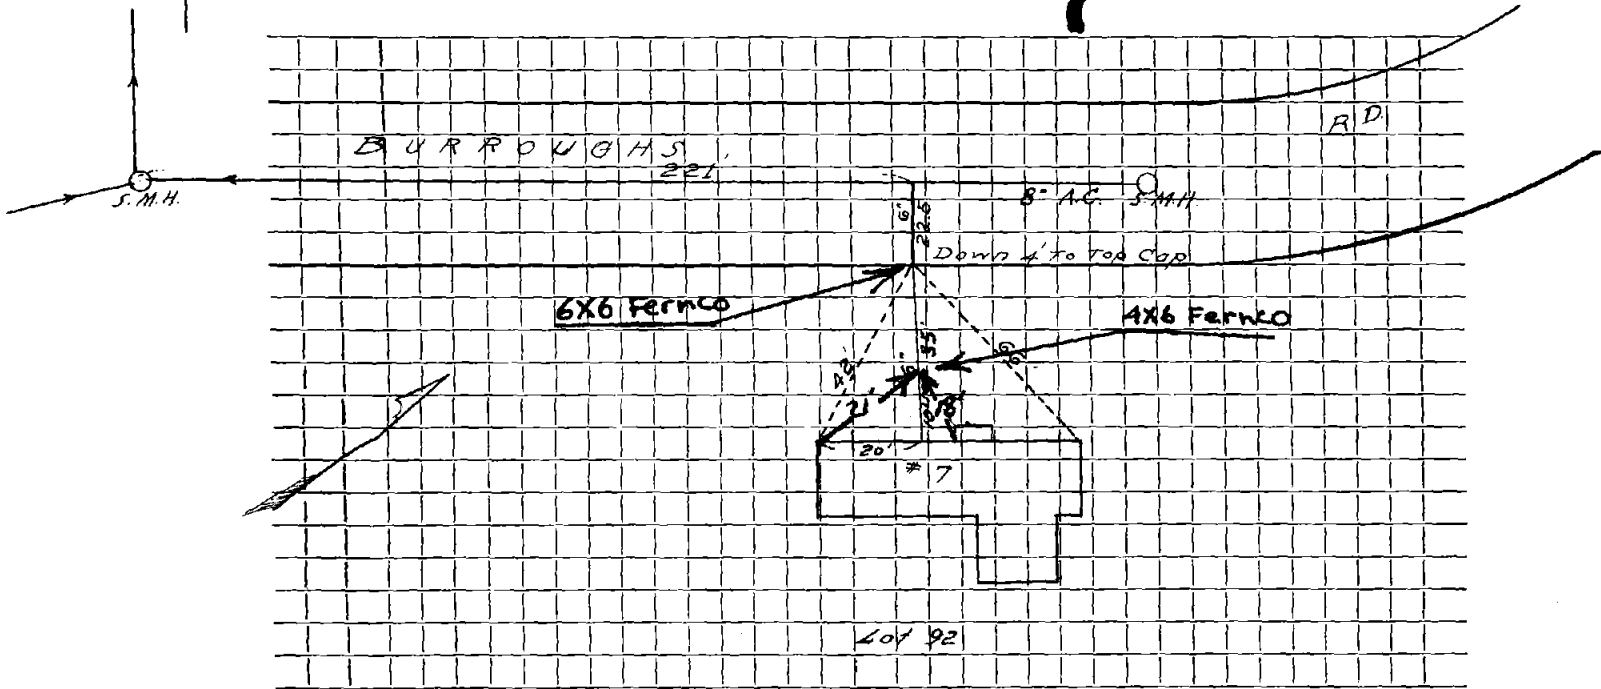

Connection made in ..... Street. Work completed .....

Remarks: .....

.....

.....