

Name

Service No. 4084

Address

28 Burnough Rd.

Location

Kind of Pipe PVC

Size 6"

Size of Main 10" A.C.

Repair—Renewal—New Service

J. McLaughlin


Location 10T 9/Pg 69

Date	Material	Amount	Total	Date	Amount
5/20/11	86" 4" PVC sch 40				
	2' 4" PVC				
	1 4" CLEAR OUT				
	4' 4" PVC				
	1 4x6 Ferroco				
	78" 6" PVC				
	1 6" 45" bend				
	54' 6" PVC				
	1 6" PVC AS FERROCO				
	EXISTING				
1968	27' 6" AS DWN 6'				

DATE \_\_\_\_\_

TOWN OF LEXINGTON — BOARD OF PUBLIC WORKS  
SEWER DIVISION

Sketch of Service Here

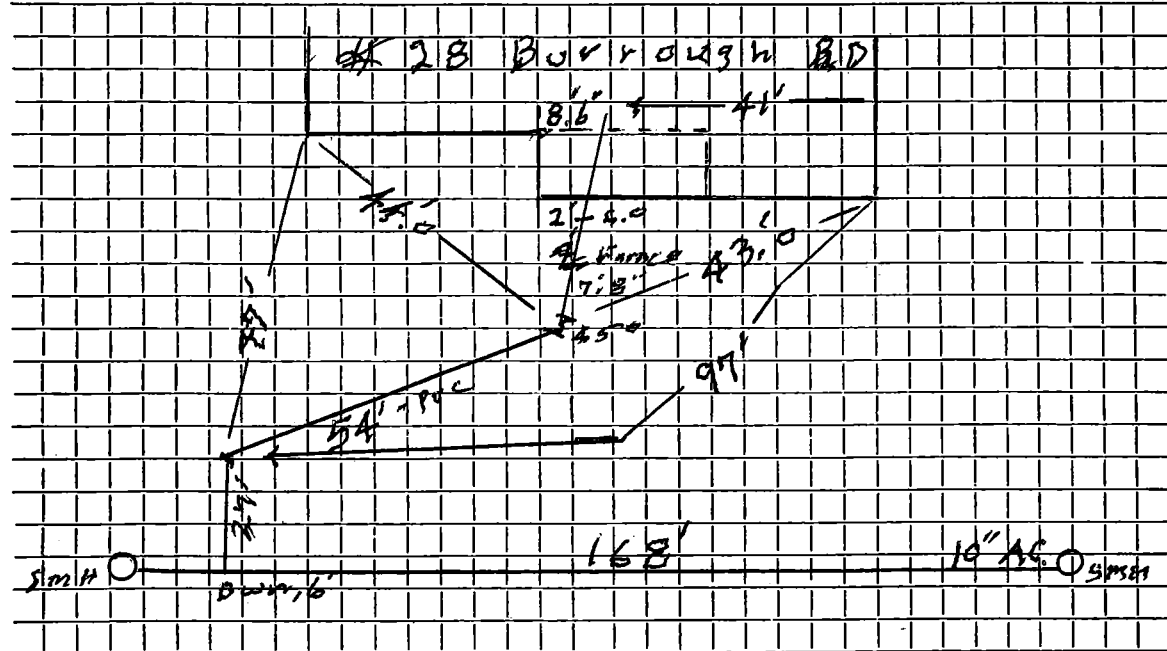

Connection made in ..... Street.

Work completed 5/2011 J. McLaughlin

Remarks: .....  
.....  
.....