

**Name** William H. Sullivan **Service No.**  
**Address** 1 Bushnell Drive  
**Location**

**Kind of Pipe** **Size** **Size of Main**  
**Repair—Renewal—New Service** Lucente #1130 **Location**  
 Sibley #1251


Date	Material	Amount	Total	Date	Amount
12-6-68	82' 6" Transite pipe				
	10' 4" Cast Iron pipe				
<del>7-31-68</del>	<del>5' 6" Transite pipe</del>			7-31-68	5' 6" Transite

DATE \_\_\_\_\_

# TOWN OF LEXINGTON — BOARD OF PUBLIC WORKS

## SEWER DIVISION

Sketch of Service Here

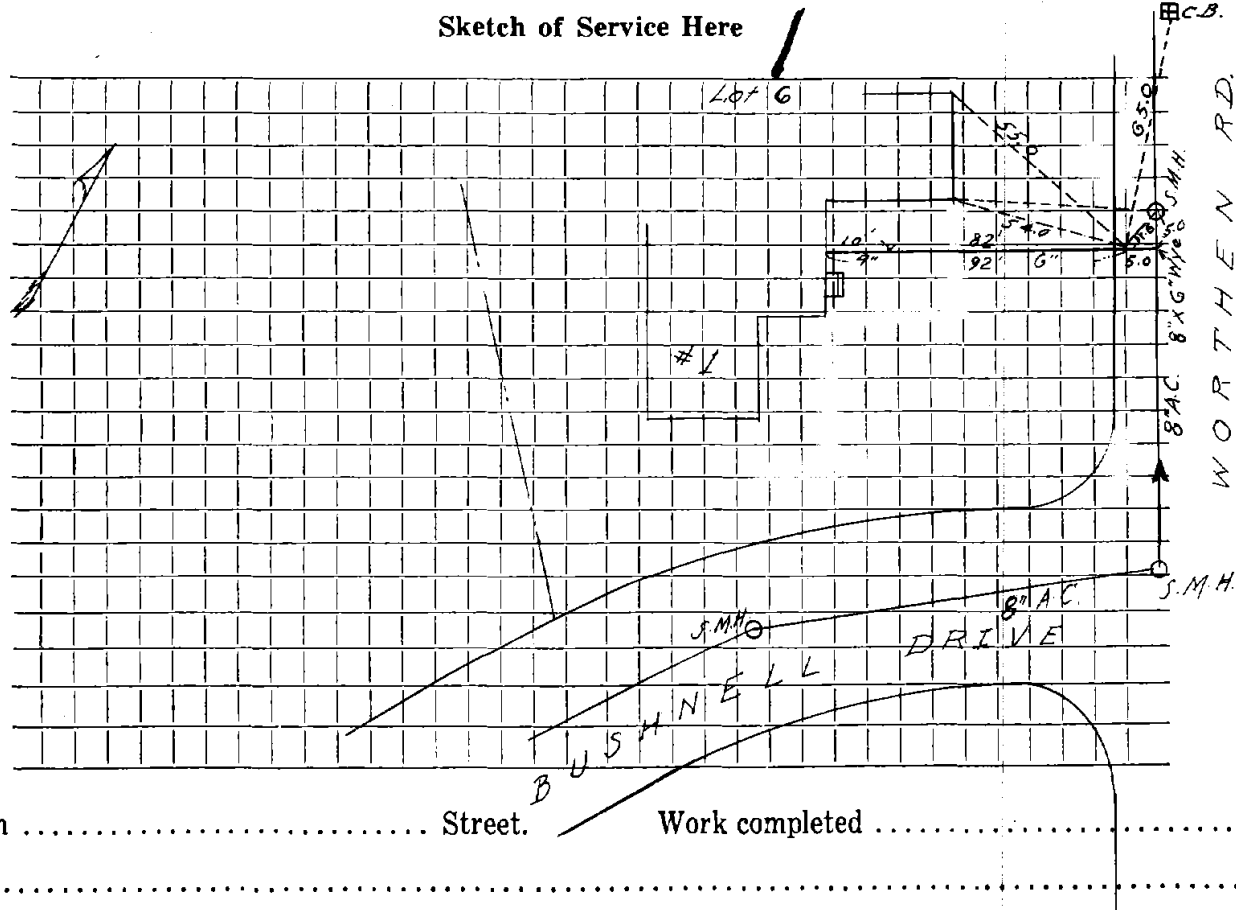

Connection made in ..... Street. Work completed .....

Remarks: .....  
.....  
.....