

Name William Sullivan

Service No.

Address 70 Bushnell Drive

lot #2A

Location

Kind of Pipe

Size

Size of Main

Repair—Renewal—New Service

Lucente #1135
Sibley #1342

Location

Date		Material	Amount	Total	Date	Amount
5-9-69	56'	6" Transite pipe				
	10'	4" Cast Iron pipe				
8-2-68	45'	6" Transite pipe			8-2-68	
					45' 6" Transite	


DATE _____

TOWN OF LEXINGTON — BOARD OF PUBLIC WORKS

SEWER DIVISION

Sketch of Service Here

10

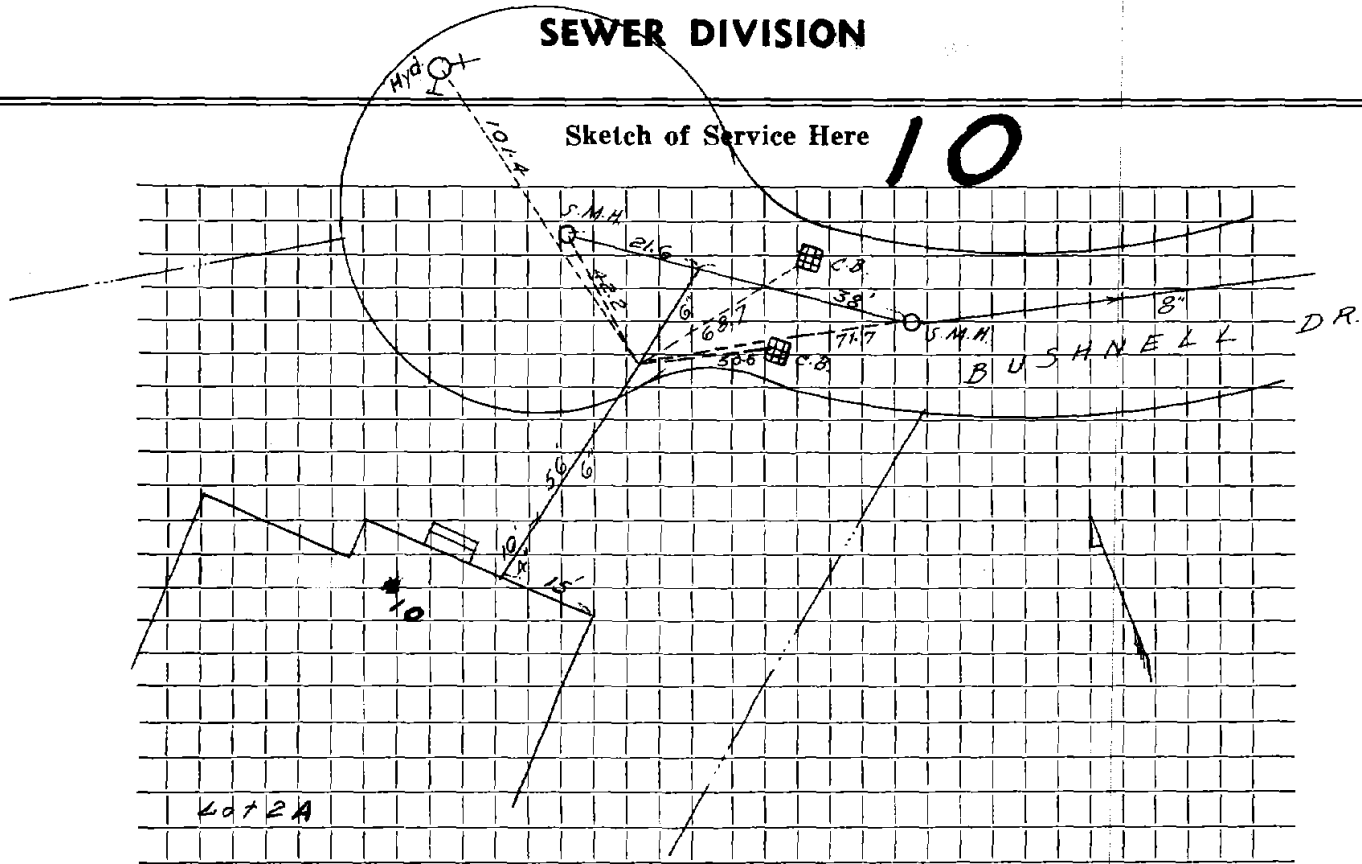

Connection made in Street. Work completed

Remarks:

.....

.....