

Name	William Sullivan	Service No.	
Address	2 Bushnell Drive		
	lot 8		
Kind of Pipe		Size	Size of Main
Repair—Renewal—New Service	Lucente #1131		Location


Date	Material	Amount	Total	Date	Amount
7-31-68	27' 6" Transite pipe				
12-3-74					
	23' 6" Transite			7-31-68	
	10' 4" Cast Iron			27' 6" Transite	

DATE _____

TOWN OF LEXINGTON — BOARD OF PUBLIC WORKS

SEWER DIVISION

Sketch of Service Here **2**

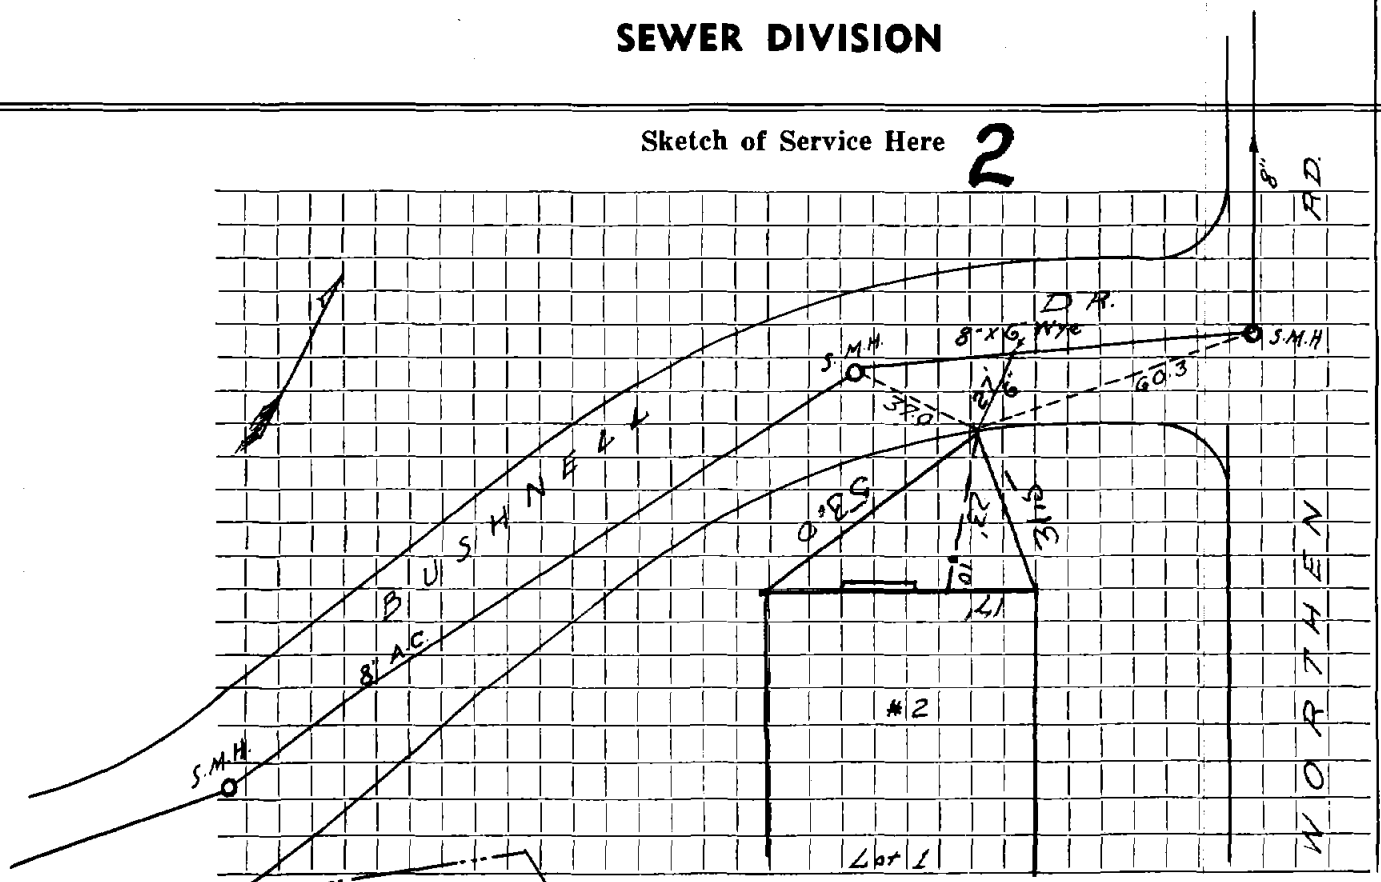

Connection made in Street. Work completed

Remarks:
.....
.....