

Name William Sullivan

Service No.

Address 3 Bushnell Drive

lot #5

Location

Kind of Pipe

Size

Size of Main

Repair—Renewal—New Service Lucente #1132


Location

Date	Material	Amount	Total	Date	Amount
<del>8-16-68</del>	<del>31' 6" Transite pipe</del>				
10-22-69					
	30' 6" Transite			8-16-68	
	10' 4" Cast Iron			31' 6" Transite	

DATE \_\_\_\_\_

TOWN OF LEXINGTON — BOARD OF PUBLIC WORKS

SEWER DIVISION

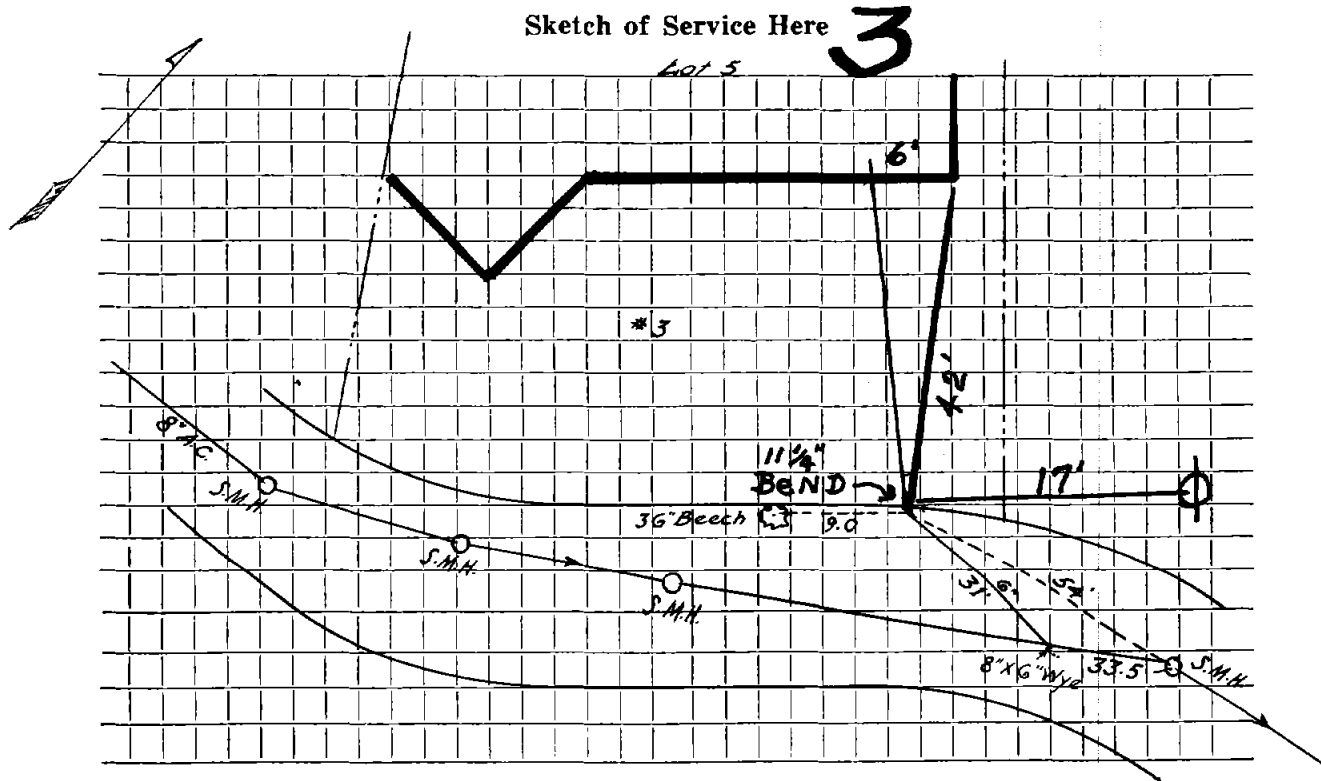

Connection made in ..... Street. Work completed .....

Remarks: .....

.....

.....