


Name	William Sullivan		Service No.
Address	5 Bushnell Drive		
	lot 4		Location
Kind of Pipe		Size	Size of Main
Repair—Renewal—New Service	Lucente #1134 Sibley #1388		Location

Date	Material	Amount	Total	Date	Amount
6-30-69	88' 6" Transite pipe				
	10' 4" Cast Iron Pipe				
8-16-68	36' 6" Transite pipe			8-16-68	
				36' 6" Transite	

TOWN OF LEXINGTON — BOARD OF PUBLIC WORKS

SEWER DIVISION

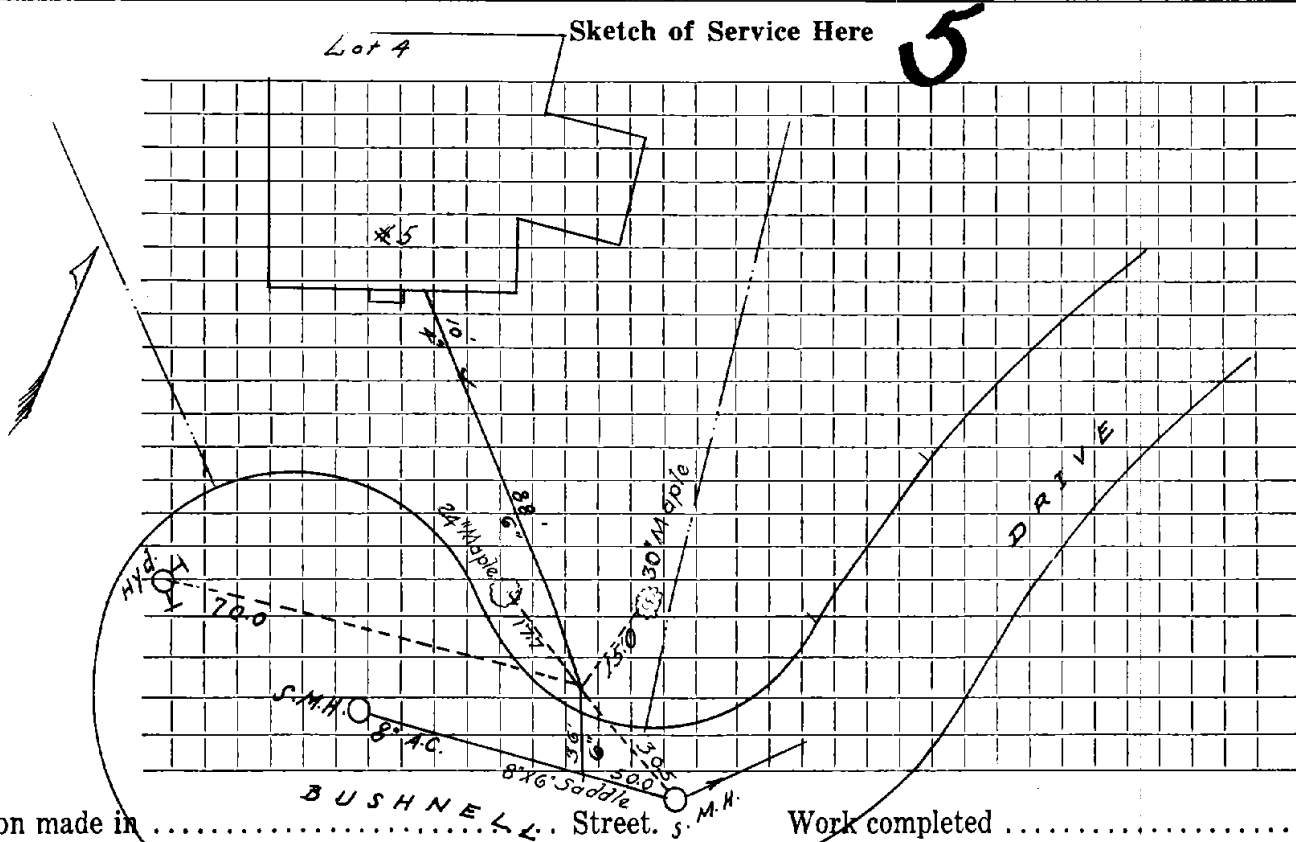

Connection made in Work completed

Remarks:
.....
.....