

Name Wm. H. Sullivan **Service No.**
Address 6 Bushnell Drive

Location Lot #8

Kind of Pipe **Size** **Size of Main**


Repair—Renewal—New Service Lucente #1137 **Location**

Date	Material	Amount	Total	Date	Amount
7-31-68	23' 6" Transite Pipe				
				7-31-68	
					23' 6" Transite

DATE _____

TOWN OF LEXINGTON — BOARD OF PUBLIC WORKS
SEWER DIVISION

Sketch of Service Here

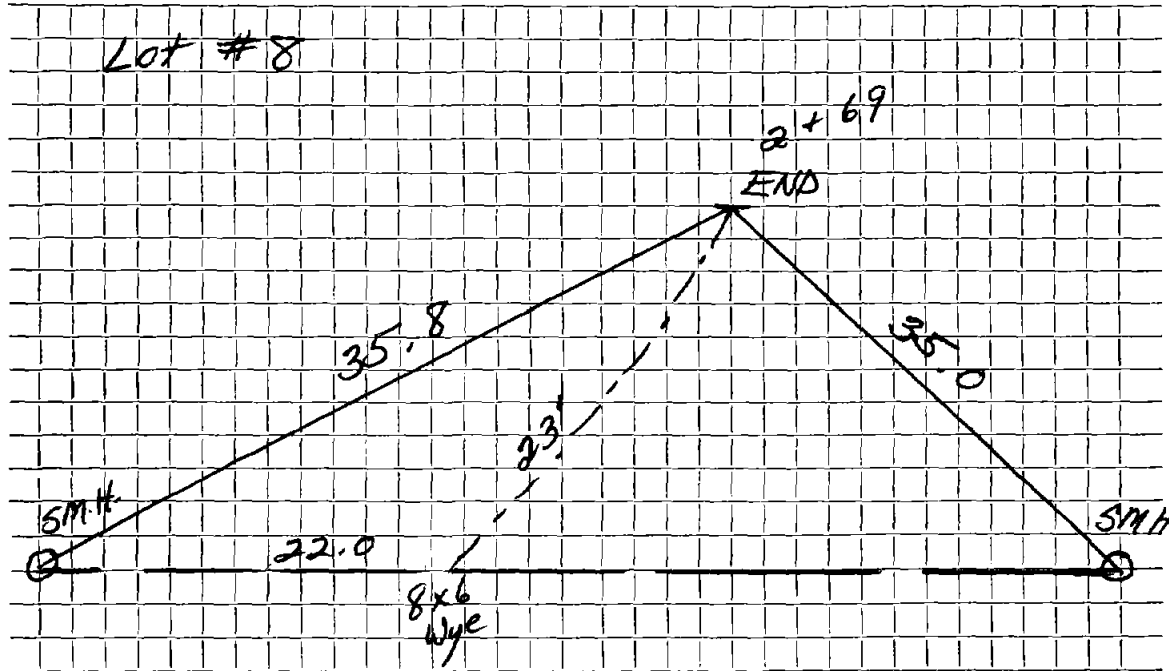

Connection made in Street. Work completed

Remarks:

.....

.....