

Name

Service No.

Address 7 DUSHNELL

FROTTEN

Location

Kind of Pipe

Size

Size of Main

Repair—~~Renewal~~—New Service

Location

Date

Material

Amount

Total

Date

Amount

6/11/14

6" SDR

42'

1 6" CLEAN OUT

• 6" SDR PLUG

• 6" PVC CAP

• 6" TEE WYE


6x 6" FURNACE

(2)

DATE 6/11/14

TOWN OF LEXINGTON — BOARD OF PUBLIC WORKS
SEWER DIVISION

Sketch of Service Here

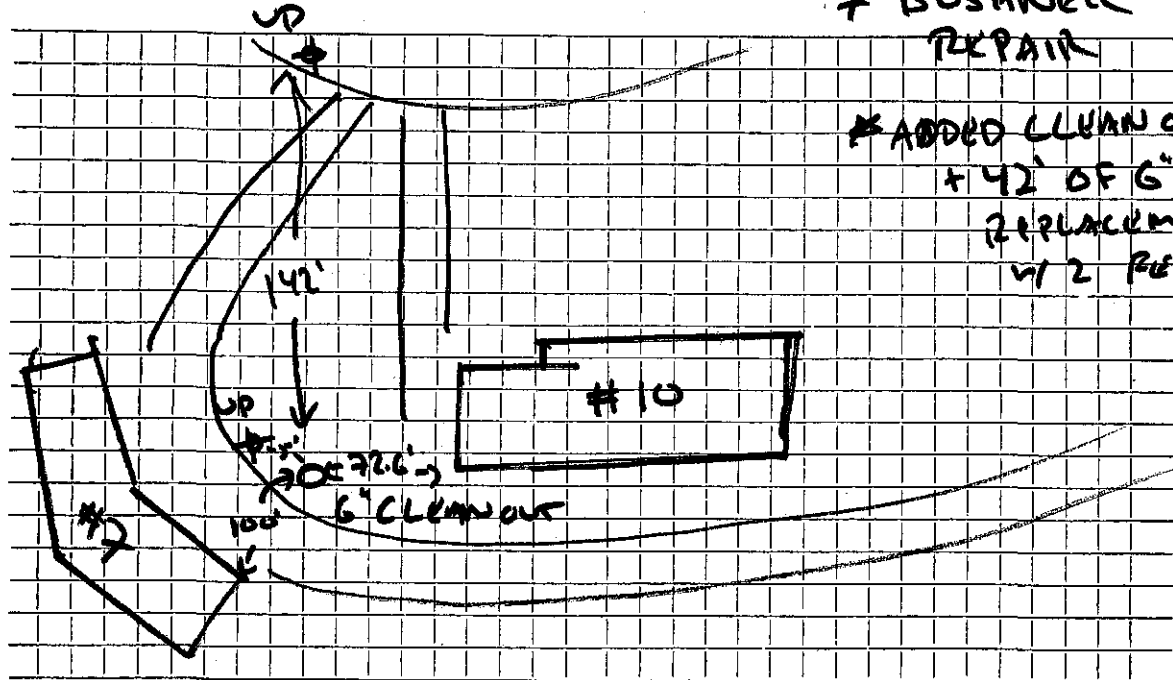

7 BUSHNELL
REPAIR

* ADDED CLEAN OUT
+ 42' OF 6" SDP
REPLACEMENT
w/ 2 REARMS

Connection made in BUSHNELL Street.

Work completed SCOTT FRUTTON

Remarks: