

Name

Service No.

Address

9 BUSHNELL DR

Location

Kind of Pipe

PVC

Size 6"

Size of Main

8 AC

Repair—Renewal—

~~New~~

Service

McLAUGHLIN

Location


Date	Material	Amount	Total	Date	Amount
7/10/79	42'-6" AC PIPE WYE DWN 4.5'	17° FT	714.00		
3/14/00	4 6" WYE CLEANOUTS				
	6 22° BENDS				
	1 45° bend				
	1 11.25 bend				
	1 4X6 FERRISCO				
	300' 6" PVC				
	4' EXIST 4" CIP				

DATE \_\_\_\_\_

# TOWN OF LEXINGTON — BOARD OF PUBLIC WORKS

## SEWER DIVISION

Sketch of Service Here

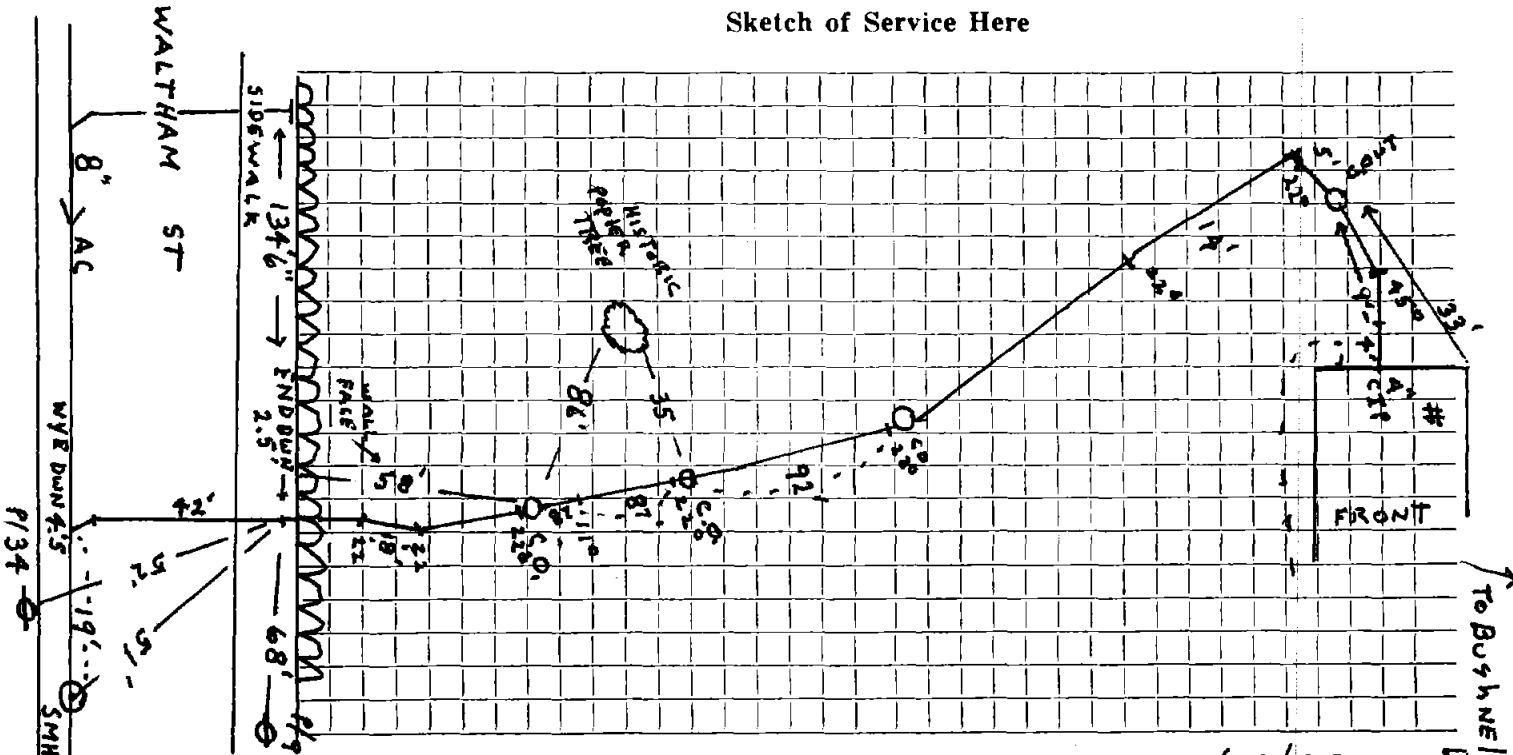

Connection made in WALTHAM ST Street.

Work completed 3/14/00 DR.

Remarks: 6" AC ENCASED IN CONCRETE