

Name Wesley Nelson

Service No. 20

Address 19 Butler Avenue

Location

OCT 25 1965

Kind of Pipe

Size

Size of Main

~~Repair or Renewal~~ — New Service Lexington Landscaping Permit #227 - W.O.#9621

Location

Date		Material	Amount		Total		Date		Amount	
4-6-65		Labor	54	43			3-25-65	Deposit	160	00
		10% O.H.	5	44	59	87	10-25-65	Retund	6	39
	15'	6" Transite pipe @.82			12	30			93	61
	3'	6" Chimney @.82			2	46				
	1	90% Ell			4	09				
	1	Duplex Adapter			2	06				
	1	Plug			1	33				
	1	Hr. Town Shovel			6	50				
	1	Hr. Town Truck			3	00				
	1/2	Hr. Loader @ 4.00			2	00				
					93	61				
4-22-65	35'	6" Transite pipe								


DATE _____

TOWN OF LEXINGTON — BOARD OF PUBLIC WORKS

SEWER DIVISION

Sketch of Service Here

19

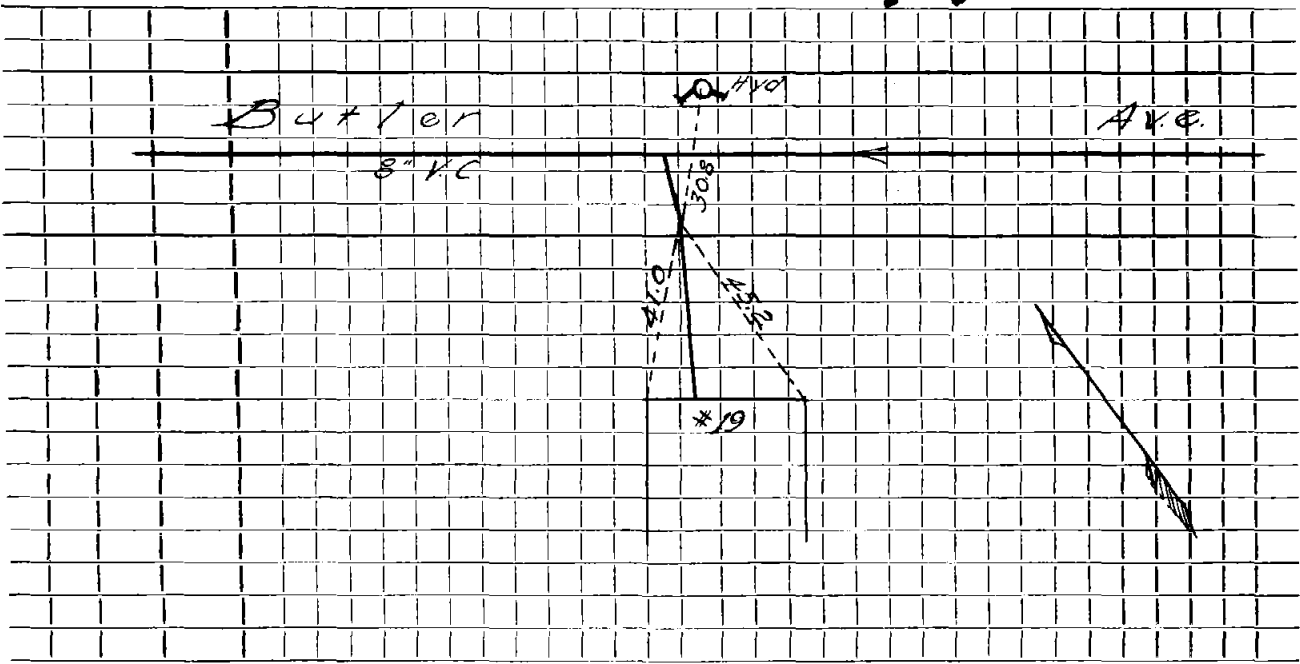

Connection made in Street. Work completed

Remarks:
.....
.....