

Name Wesley Nelson

Service No. 21

Address 23 Butler Avenue

Location

Kind of Pipe

Size

Size of Main

~~Repair/ Renewal~~ **New Service** Lexington Landscape Permit #228 - W.O.#9622


Location OCT 25 1965

Date		Material	Amount		Total		Date	Amount	
4-6-65		Labor	46	20			3-25-65	Deposit	100 00
		10% O.H.	4	62	50	82	10-28-65	Refund	12 80
	20'	6" Transite pipe @.82			16	40			87 20
	3'	6" Chimney @.82			2	46			
	1	90° Ell			4	09			
	1	Cap			1	93			
	1	Hr. Town Shovel			6	50			
	1	Hr. Town Truck			3	00			
	1/2	Hr. Loader			2	00			
					87	20			
4-16-65	30'	6" Transite pipe							

DATE _____

TOWN OF LEXINGTON — BOARD OF PUBLIC WORKS
SEWER DIVISION

Sketch of Service Here **23**

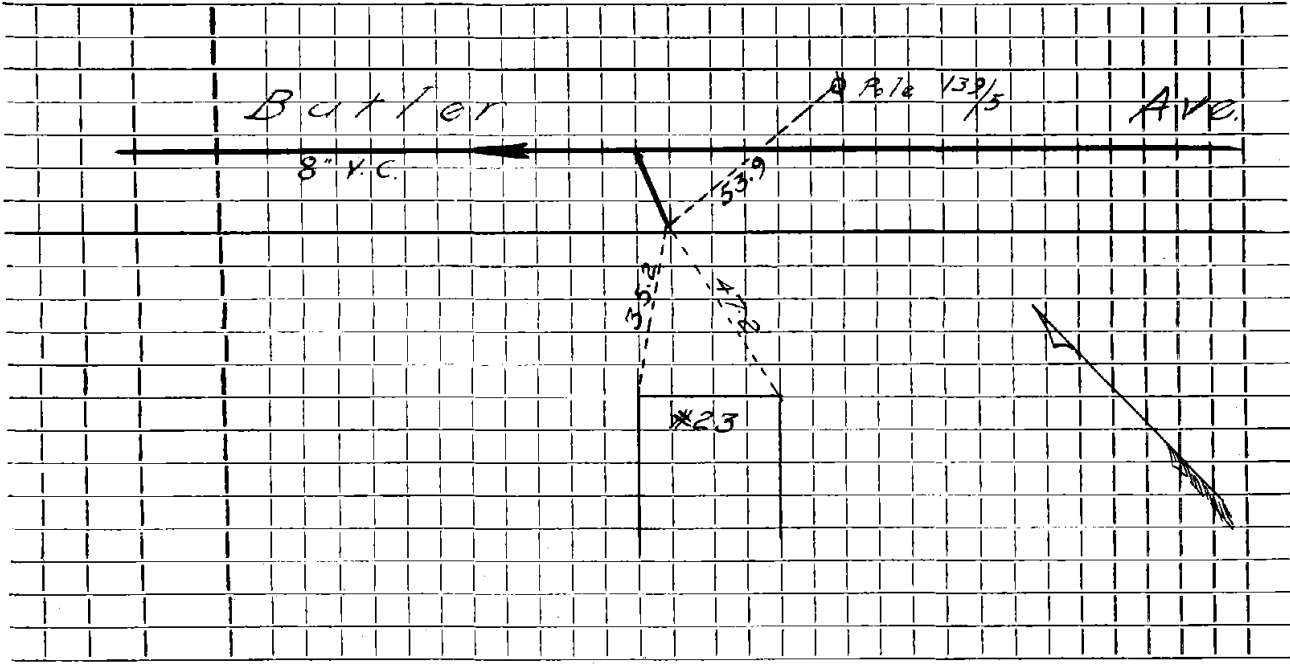

Connection made in Street. Work completed

Remarks:
.....
.....