

Name William G. Wright

Service No. 35

Address 26 Butler Avenue

Location

Kind of Pipe

Size

Size of Main

~~Repair~~ ~~Renewal~~ New Service com. 7-18-55

Location

Date	Material	Amount	Total	Date	Amount
5/20/55	Labor	26 94		4-4-55	Deposited 150 00
	10% overhead	2 69	29 63	7-18-55	Refunded (56 79)
	40' - 6" sewer pipe @ .32		12 80		93 21
	1 - 6" elbow		1 88		
	joint compound		2 40		
	6 hrs. Littlefield shovel @ 7.50		45 00		
	2 hrs. trucking @ .75		1 50		
			93 21		
	<b>Labor</b>			12-2-59	Root 12' 3rd pipe

TOWN OF LEXINGTON—DEPT. OF PUBLIC WORKS  
**SEWER DIVISION**

DATE.....

NO. ....

The undersigned applies for the construction of a particular sewer connecting No.....  
Street and hereby agrees to comply with the Rules and Regulations governing the construction and use of Particular  
Sewers, as now or at any future time established by the Board of Selectmen.


Am't of estimate \$.....

Am't Paid \$.....

..... Owner

*BUTLER*

Sketch of Service Here **26**

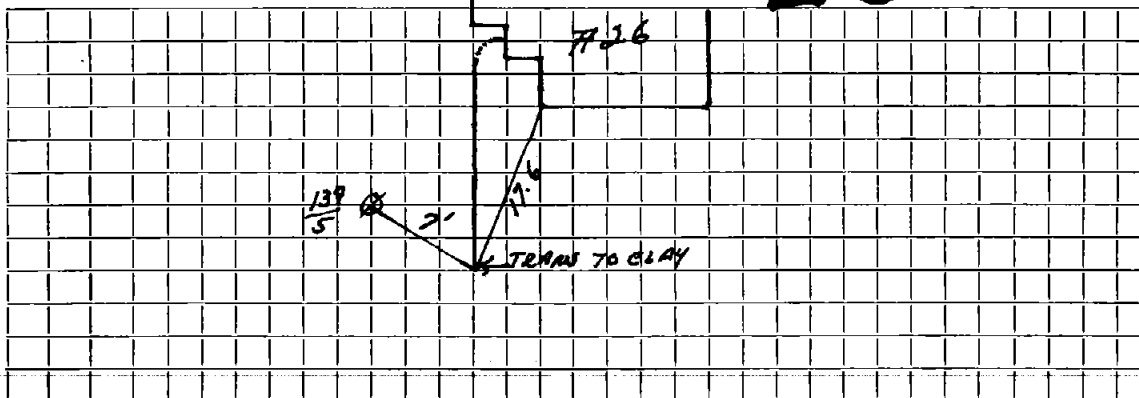

Connection made in..... Street.

Work completed.....19..

Remarks: