


DATE _____

TOWN OF LEXINGTON — BOARD OF PUBLIC WORKS

SEWER DIVISION

Sketch of Service Here

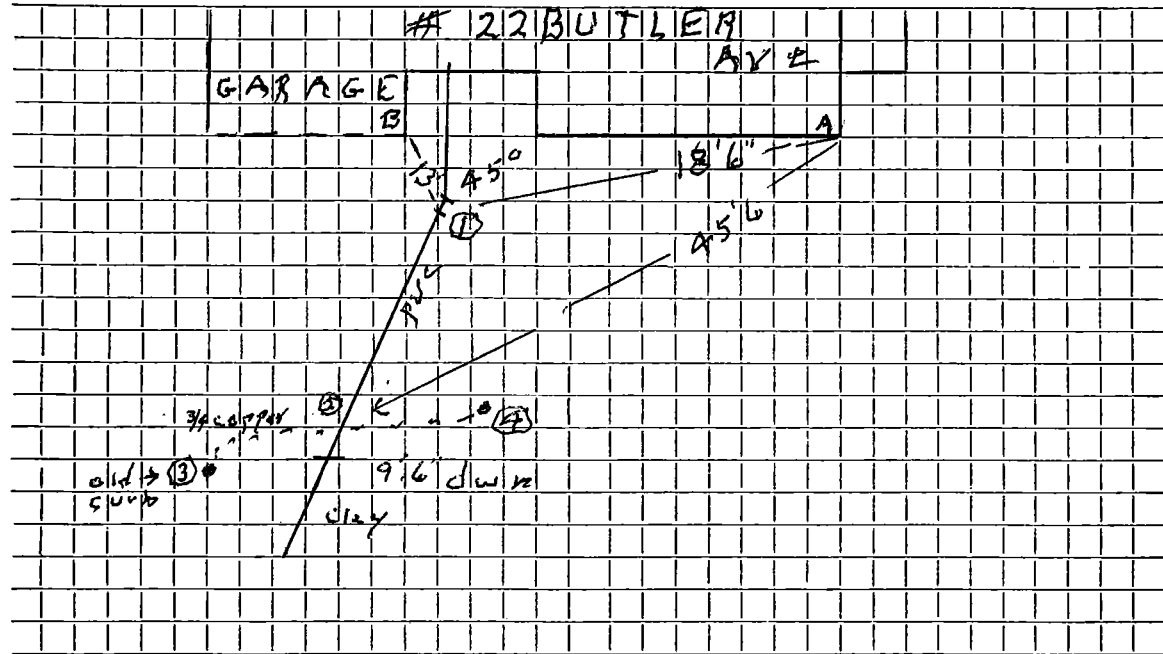

- A-1 = 18.6
- A-2 = 45.6
- A-3 = 49.8
- A-4 = 42.9
- B-1 = 13'
- B-2 = 37.6
- B-3 = 42
- B-4 = 37

Connection made in Street.

Work completed Feb 2012 Rec'd mon of D.P.W.

Remarks:

.....

.....