




DATE \_\_\_\_\_

TOWN OF LEXINGTON — BOARD OF PUBLIC WORKS

SEWER DIVISION

Sketch of Service Here

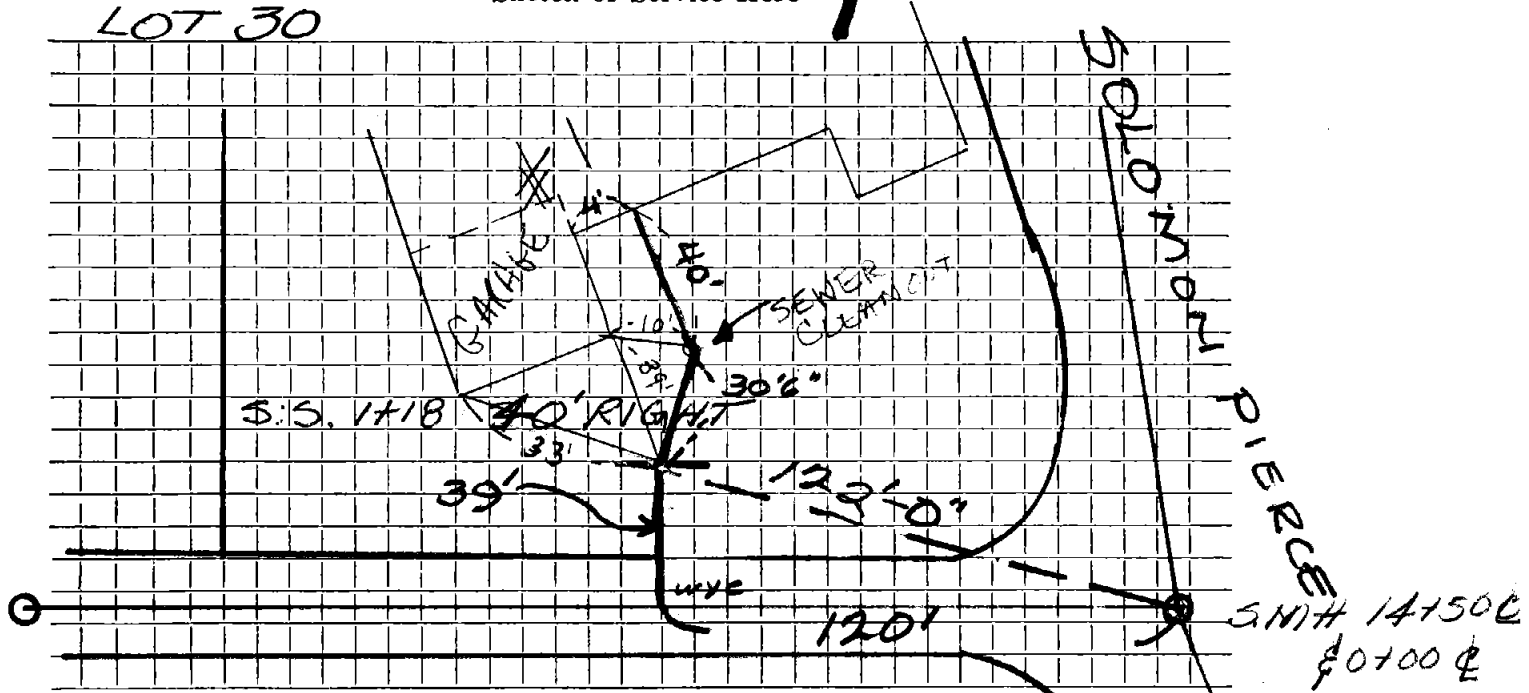

Connection made in BUTTER FIELD Street. Work completed .....

Remarks: DEPTH = 7'  
.....  
.....