


DATE 8/1/94

TOWN OF LEXINGTON — BOARD OF PUBLIC WORKS
SEWER DIVISION

Sketch of Service Here **10**

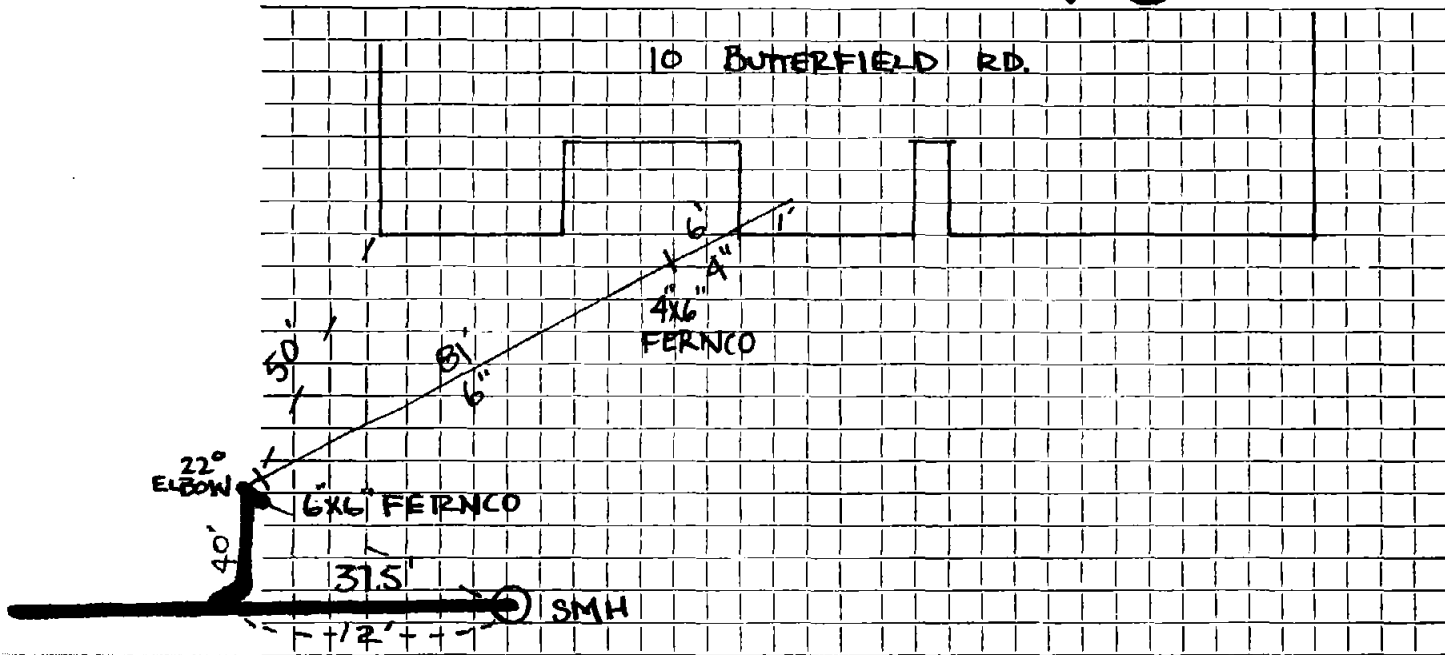

Connection made in Street. Work completed

Remarks:
.....
.....