

Name

Service No.

Address 12 BUTTERFIELD RD. (LOT 2)

Location

Kind of Pipe PVC

Size 6"

Size of Main 8"

Repair—Renewal—New Service


Location

Date	Material	Amount		Total		Date		Amount
<del>5/10/89</del>	53 LF 6" PVC							
	8" X 6" WYE							
						5-10-89		
							53' 6" P.V.C.	
							1 6" X 8" Wye	

DATE \_\_\_\_\_

TOWN OF LEXINGTON — BOARD OF PUBLIC WORKS  
SEWER DIVISION

Sketch of Service Here  
#12 LOT 2

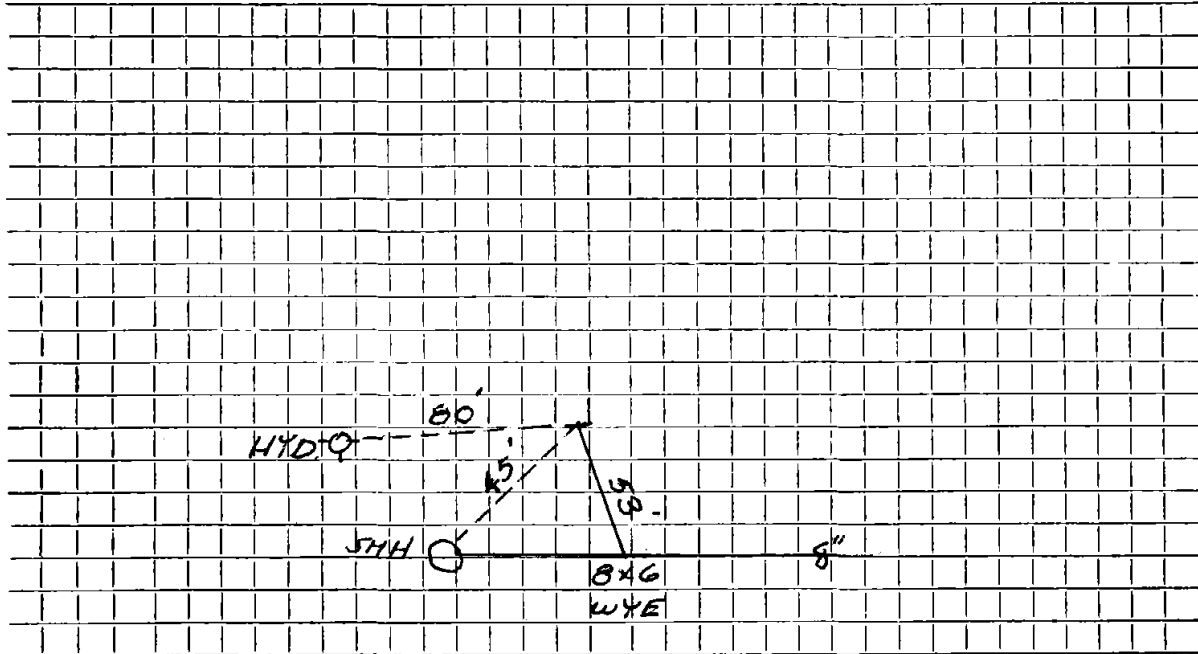

Connection made in BUTTERFIELD ROAD Street. Work completed .....

Remarks: .....  
.....  
.....