

Name Frank Corsino

Service No. 159

Address 15 Byron Avenue

Location

Kind of Pipe

Size

Size of Main

~~Repair~~ ~~Renewal~~ ~~New Service~~

Location Comm 11-16-59


Date	Material	Amount	Total	Date		Amount
9-12-59	Labor	114.74		9-3-59	Deposit	150.00
	10% O.H.	11.47	126.21	9-1-59	Paid	59.22
	58' 6" Transite pipe @.70		40.60			209.27
	1 6" Transite Bend 22 $\frac{1}{2}$ "		6.21		NON CHARGE	
	1 bag cement		1.50		Labor	57.38
	1 ton Brick Sand @ 1.00		1.00			
	12 x 3 Patch		12.00			
	3 hrs. Town Shovel @6.50		19.50			
	3 hrs. Trucking @.75		2.25			
			209.27			

DATE \_\_\_\_\_

**TOWN OF LEXINGTON — BOARD OF PUBLIC WORKS**  
**SEWER DIVISION**

Sketch of Service Here

**15**

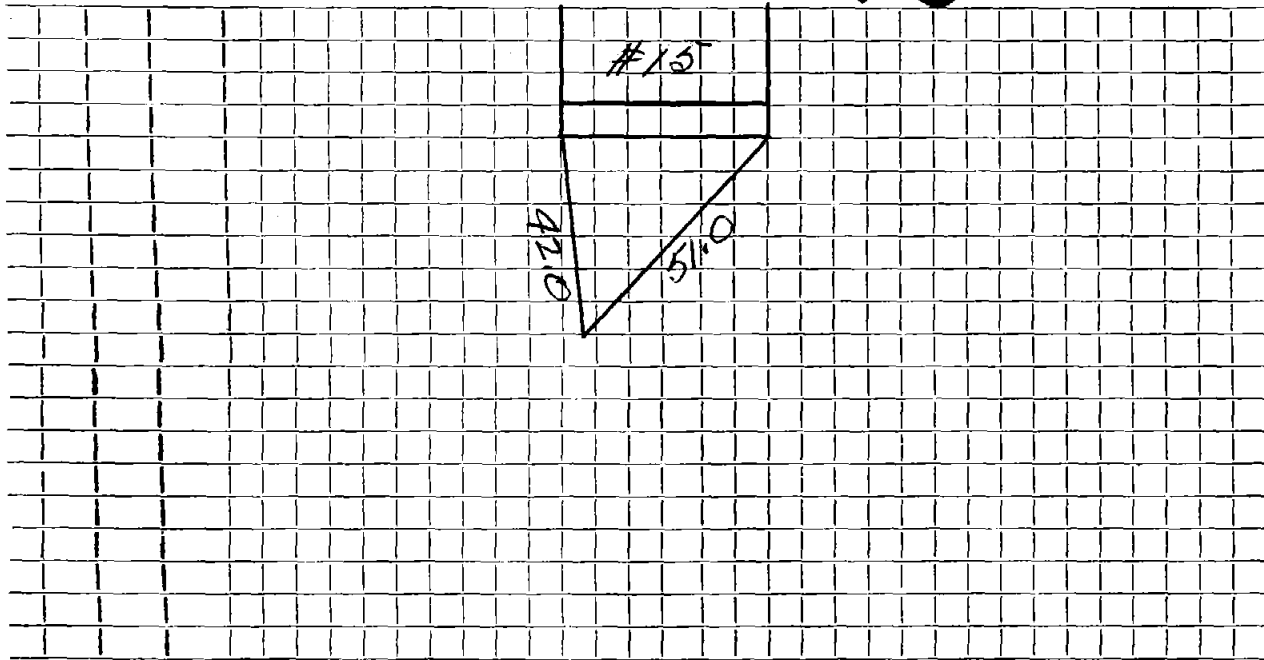

Connection made in ..... Street. Work completed .....

Remarks: .....  
.....  
.....