




DATE 11/17/94

TOWN OF LEXINGTON — BOARD OF PUBLIC WORKS  
SEWER DIVISION

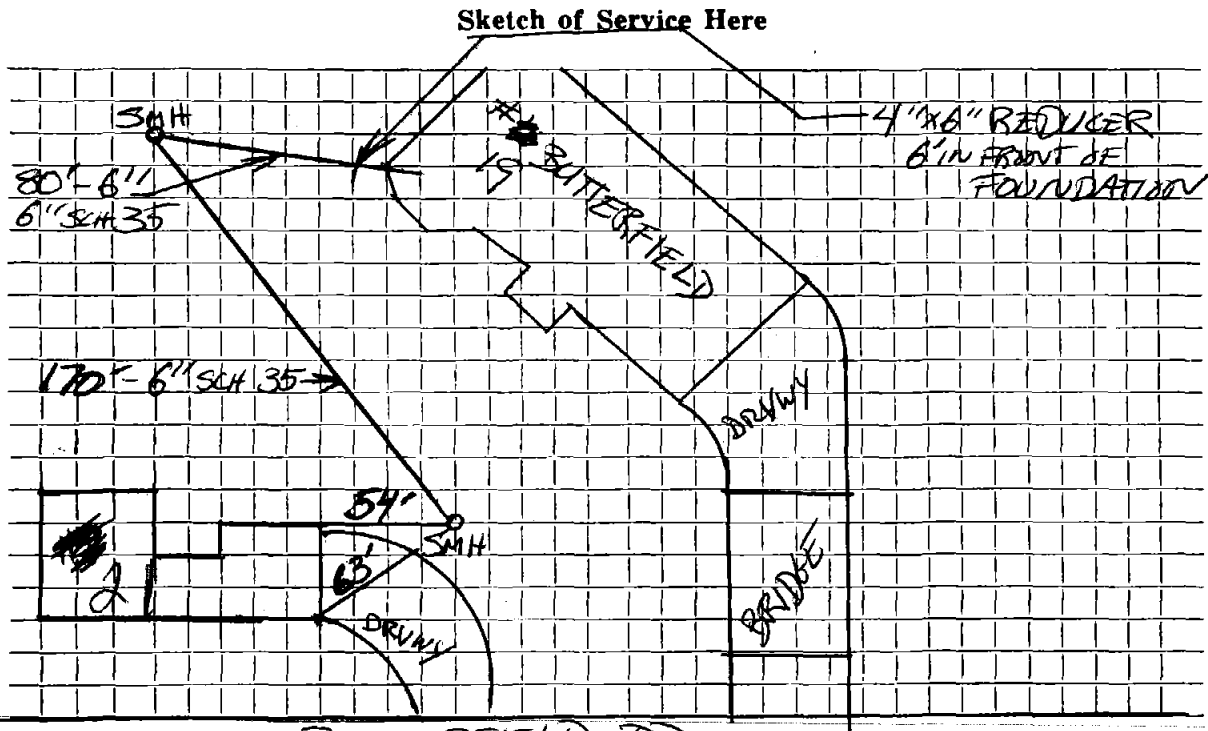

Connection made in ..... BUTTERFIELD RD Street. Work completed .....

Remarks: .....  
.....  
.....