

Name

Service No. permit 809

Address 2 Butterfield RD

Location

Kind of Pipe

Size

Size of Main

Repair—Renewal—New Service

Location

Date

Material

Amount

Total

Date

Amount

5/22/96


6" PVC

SEE BACK of CARD

DATE _____

TOWN OF LEXINGTON — BOARD OF PUBLIC WORKS
SEWER DIVISION

Sketch of Service Here

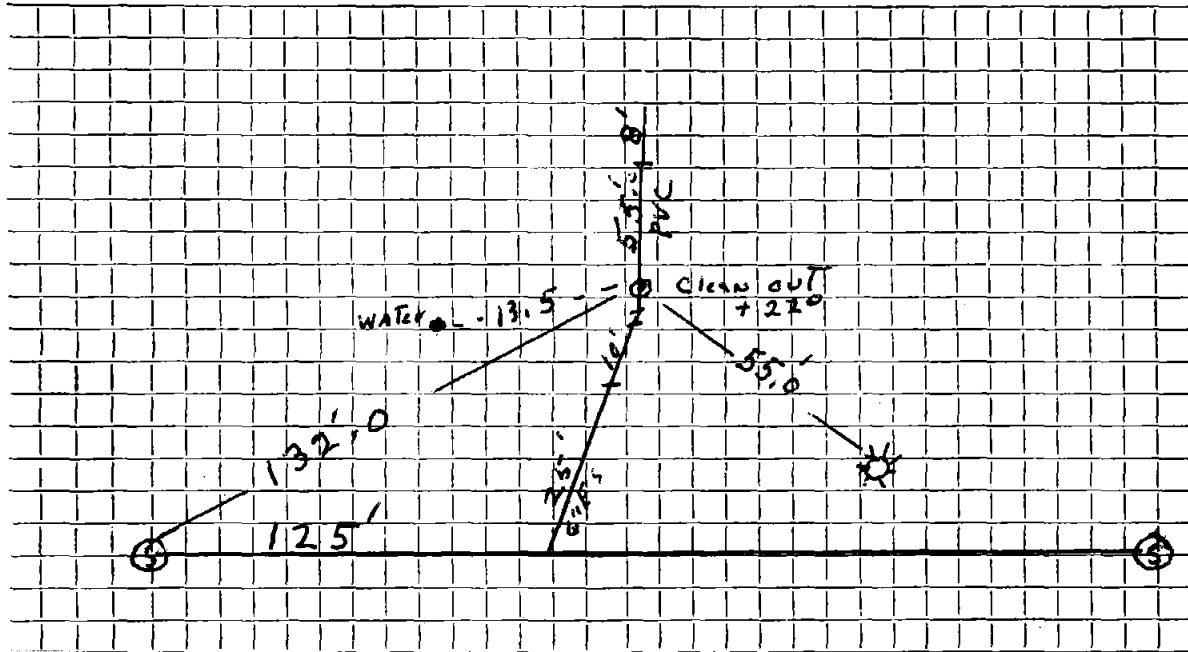

Connection made in Street. Work completed

Remarks: NO INFO ON W/O/S

.....
.....