


dfg

DATE _____

TOWN OF LEXINGTON — BOARD OF PUBLIC WORKS SEWER DIVISION

Sketch of Service Here **23**

LOT #2

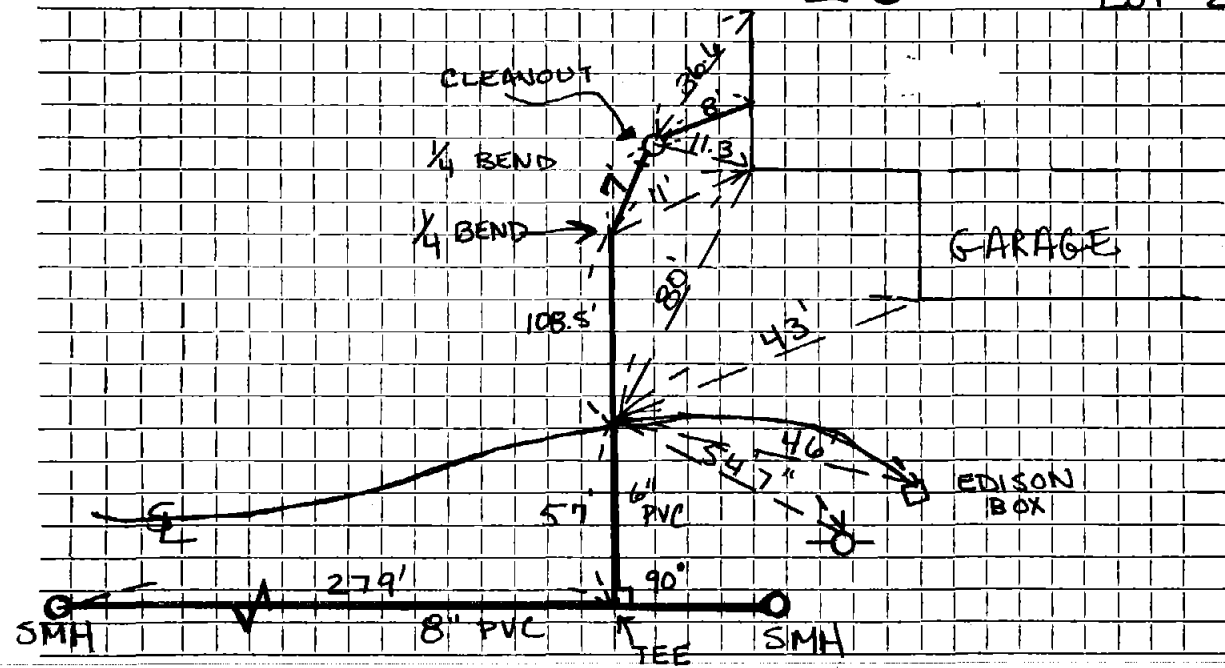

Connection made in _____ Street. Work completed

Remarks:
.....
.....