



afj


DATE \_\_\_\_\_

# TOWN OF LEXINGTON — BOARD OF PUBLIC WORKS

## SEWER DIVISION

Sketch of Service Here

# 24

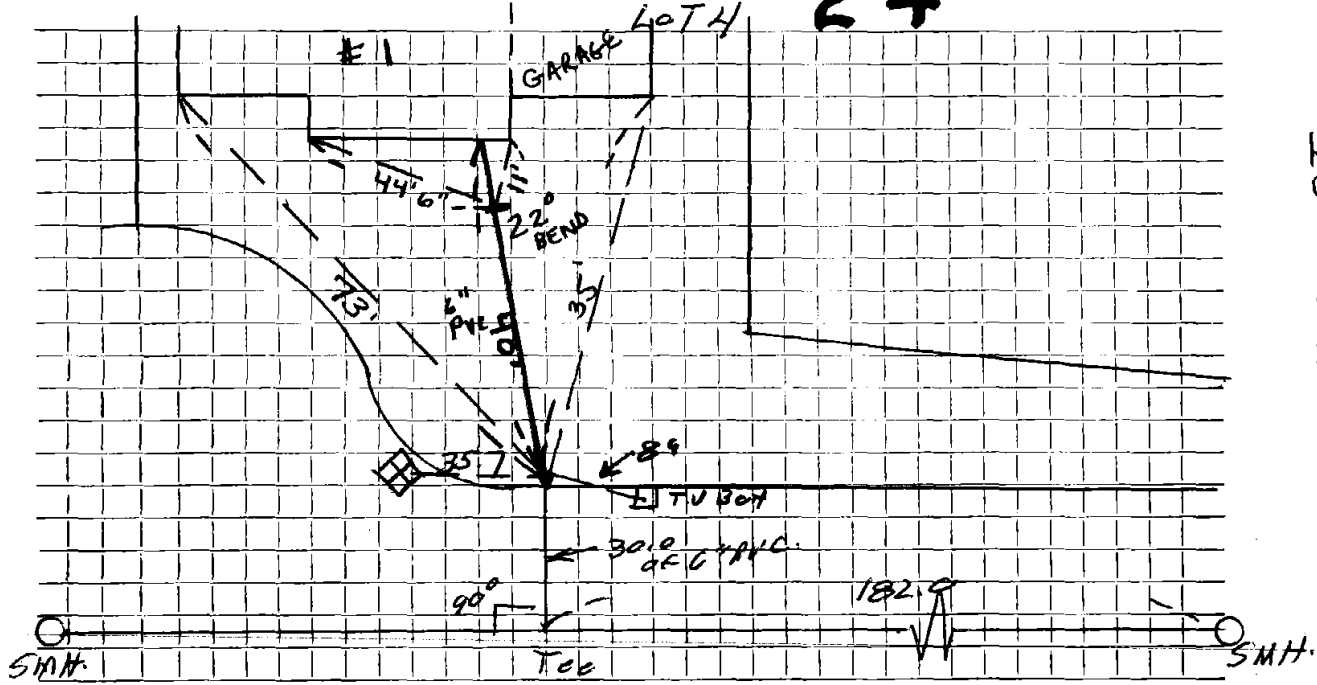

Connection made in \_\_\_\_\_ Street. Work completed \_\_\_\_\_

Remarks: \_\_\_\_\_  
\_\_\_\_\_