
DATE			
D~! E~	 	 	

## TOWN OF LEXINGTON - BOARD OF PUBLIC WORKS SEWER DIVISION

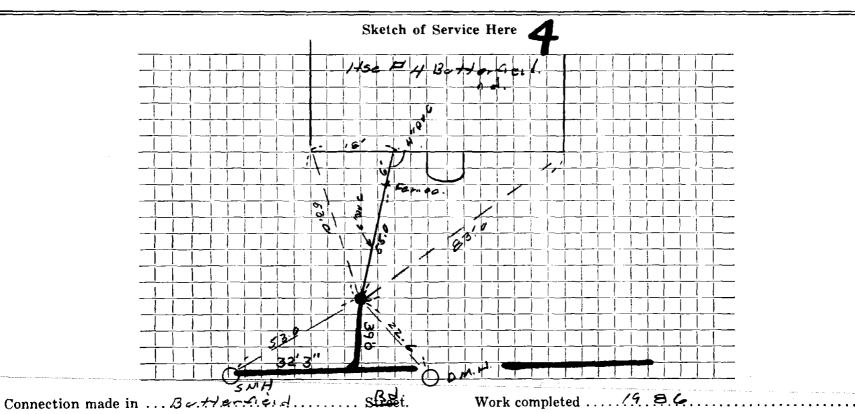

Remarks: .....