

Name BAHAA SALEH-AZZA FAHIN

Service No.

Address 7 BUTTERFIELD RD

Location

Kind of Pipe

Size

Size of Main

Repair—Renewal—New Service

NEW SERVICE

D'ELIA EXCAVATING

Location

Date

Material

Amount

Total

Date

Amount

6/20

96


6" PVC

1-4"x6" FERNCO

DATE 6/20/96

TOWN OF LEXINGTON — BOARD OF PUBLIC WORKS
SEWER DIVISION

Sketch of Service Here **7**

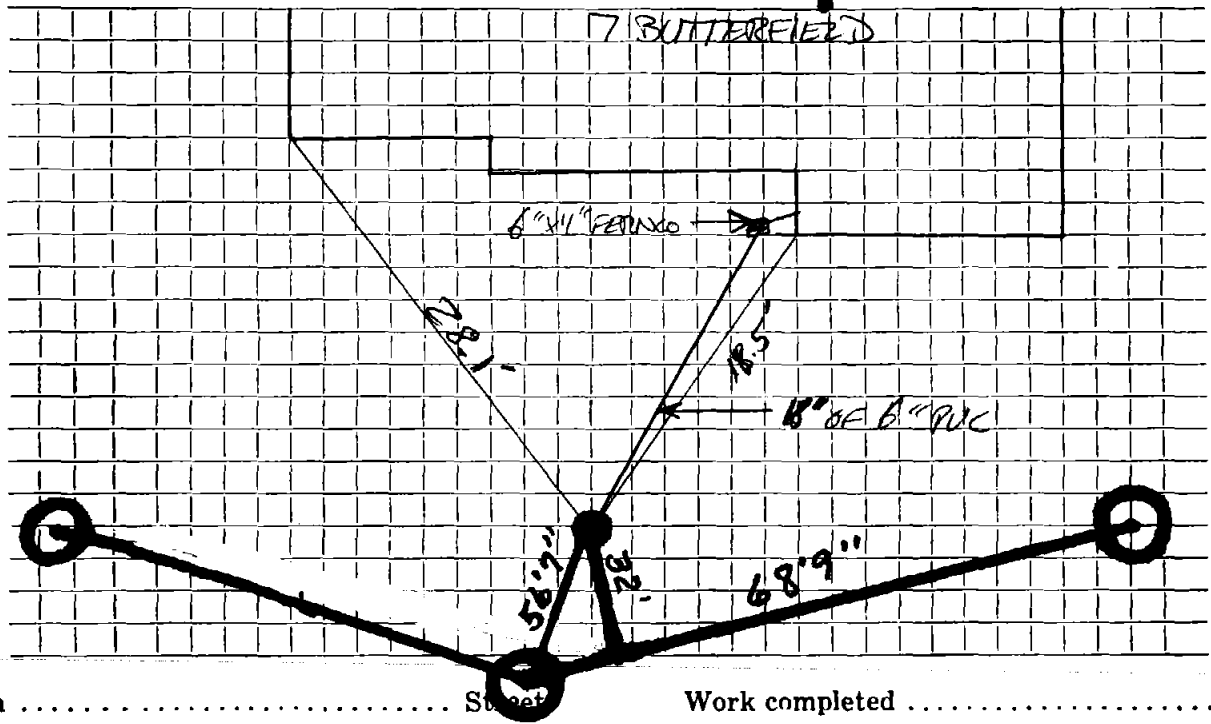

Connection made in Street Work completed

Remarks:
.....
.....