




DATE LOT # 34

TOWN OF LEXINGTON — BOARD OF PUBLIC WORKS  
SEWER DIVISION

Sketch of Service Here

8

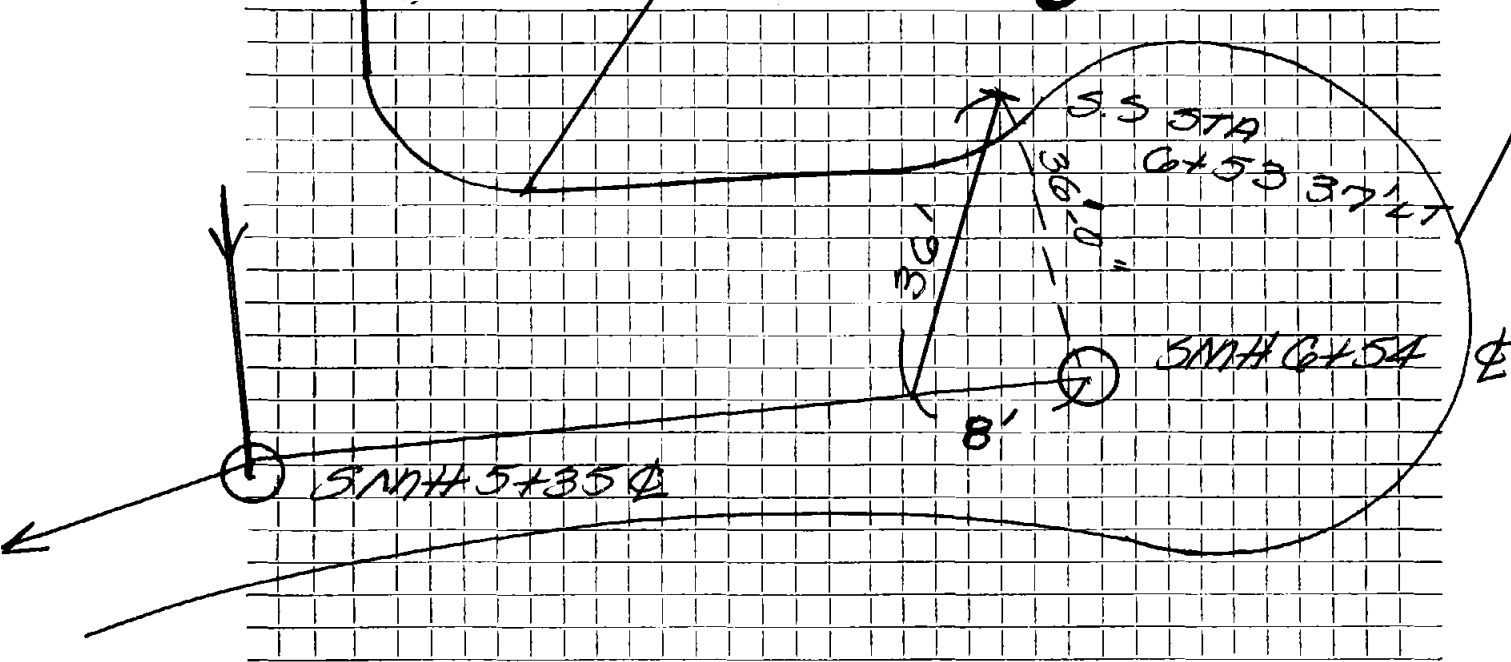

Connection made in BUTTERFIELD Street. Work completed .....

Remarks: DEPTH = 5' .....

.....  
.....