

Name William Staines

Service No. 162

Address 17 Byron Avenue

Location

Kind of Pipe

Size

Size of Main

~~REPAIR~~ ~~RENEW~~ New Service

Location Comm 11-16-59

Date	Material	Amount	Total	Date	Amount	
9-14-59	Labor	119 39		9-8-59	Deposit	200 00
	10% O. H.	11 94	131 33	11-16-59	Paid by WHC# 215	12 84
	70' 6" Transite pipe @.70		49 00	3-12-60	Paid	5 38
	1 11 1/2° Transite Bend		5 10			218 22
	1 6" 90° Transite Elbow		5 29			
	4 Hrs. Town Shovel @6.50		26 00			
	2 Hrs. Trucking @.75		1 50			
			218 22			
	Labor					

TOWN OF LEXINGTON—DEPT. OF PUBLIC WORKS  
SEWER DIVISION

DATE.....

NO.....

The undersigned applies for the construction of a particular sewer connecting No.....  
Street and hereby agrees to comply with the Rules and Regulations governing the construction and use of Particular  
Sewers, as now or at any future time established by the Board of Selectmen.


Am't of estimate \$.....

Am't Paid \$.....

..... Owner

Sketch of Service Here

17

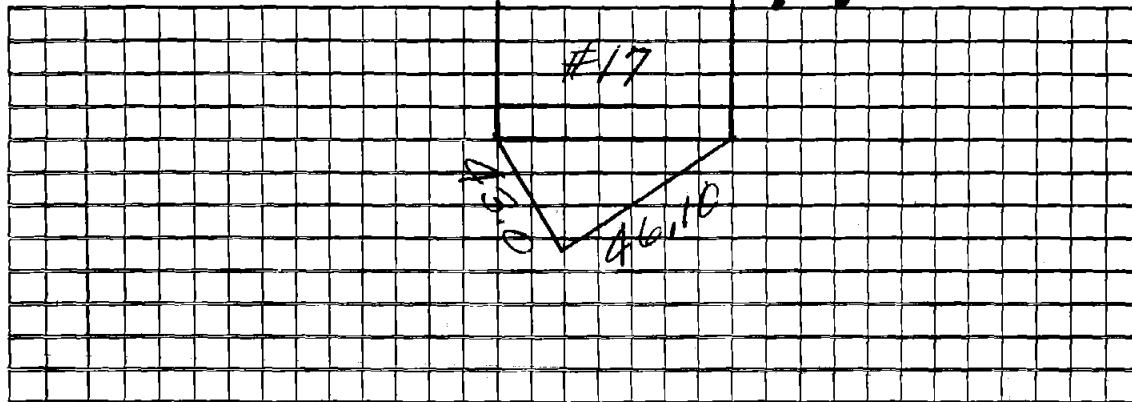

Connection made in..... Street.

Work completed..... 19..

Remarks: