

Name George McManus

Service No. 54

Address 19 Byron Avenue

Location

Kind of Pipe

Size

Size of Main

~~Repair~~ ~~Renewal~~ New Service

Location *Comm. 11-16-59*

Date	Material	Amount	Total	Date	Amount
9-11-59	Labor	159 37		5-6-59	Deposit 210 00
	10% O. H.	15 94	175 31	5-3-59	Paid 21 00
	65' 6" Transite pipe @.70		45 50	3-4-59	Paid 39 27
	1 6" Transite Band 22 $\frac{1}{2}$ ^o		6 21		NON CHARGE 257 27
	1 Bag Cement		1 50	9-10-59	Labor 27 39
	1 Ton Bricksand @1.00		1 00		
	6 $\frac{1}{2}$ Ton 1 $\frac{1}{4}$ " Stone @1.50		9 75		
	12 x 3 Patch		12 00		
	1 Hr. Trucking		3 00		
	1 Hr. Rogers Trailer @3.00		3 00		
			257 27		
	Labor				

TOWN OF LEXINGTON—DEPT. OF PUBLIC WORKS
SEWER DIVISION

DATE.....

NO.

The undersigned applies for the construction of a particular sewer connecting No.....
Street and hereby agrees to comply with the Rules and Regulations governing the construction and use of Particular
Sewers, as now or at any future time established by the Board of Selectmen.


Am't of estimate \$.....

Am't Paid \$.....

..... Owner

Sketch of Service Here

19

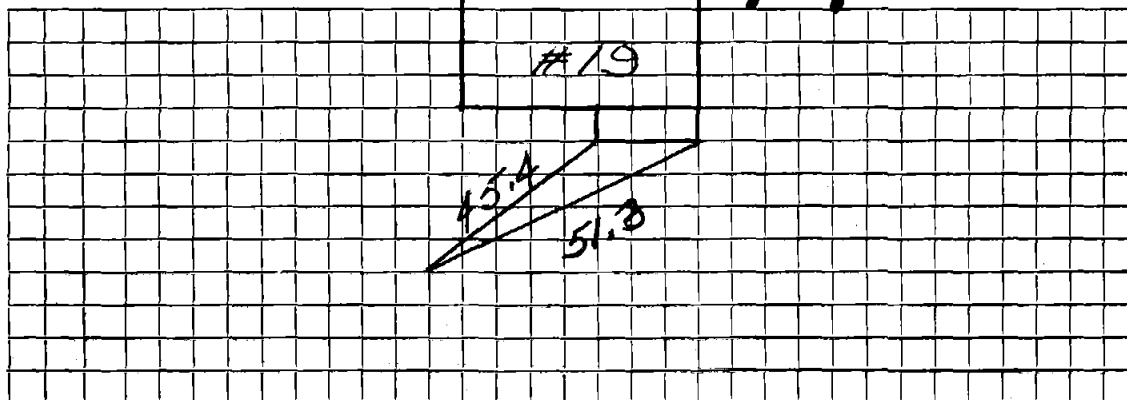

Connection made In..... Street.

Work completed.....19..

Remarks: