

Name Francis Costello Jr.

Service No. 175

Address 21 Byron Avenue

Location

Kind of Pipe

Size

Size of Main

~~Repair~~ ~~Renewal~~ New Service

Location *Comm 11-30-59*


Date	Material	Amount	Total	Date	Amount
9-15-59	Laobr	88.86		<i>9-4-59</i>	<i>200.00</i>
	10% O.H.	8.89	97.75	<i>11-30-59</i>	<i>16.16</i>
58'	6" Sewer pipe @.70		40.60		<i>189.90</i>
6 1/4	ton 3/4" Stone @1.50		9.38		
6 1/2	ton 1/4" Stone @1.50		9.75		
2	22 1/2° Transite Bends @6.21		12.42		
5	X 3 Patch		5.00		
3	hrs. pippin Shovel @4.50		13.50		
2	hrs. Trucking @.75		1.50		
			189.90		

DATE _____

TOWN OF LEXINGTON — BOARD OF PUBLIC WORKS
SEWER DIVISION

Sketch of Service Here

21

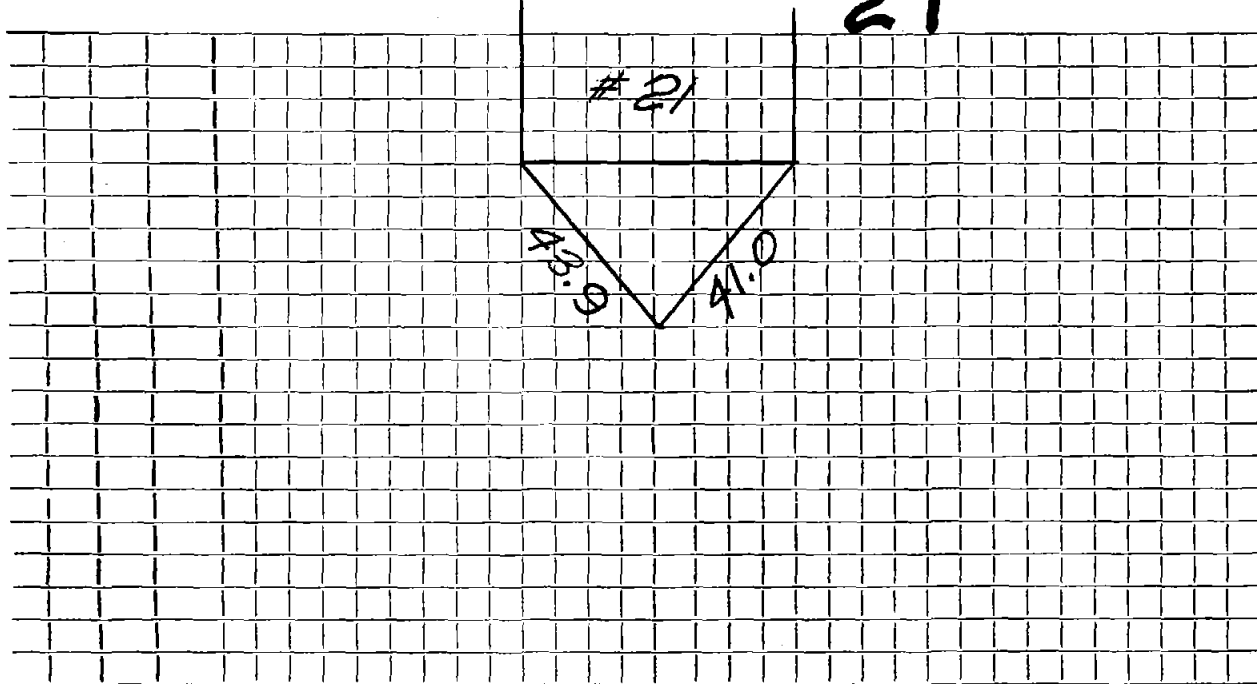

Connection made in Street. Work completed

Remarks:

.....
.....