




DATE \_\_\_\_\_

TOWN OF LEXINGTON — BOARD OF PUBLIC WORKS

SEWER DIVISION

Sketch of Service Here **23**

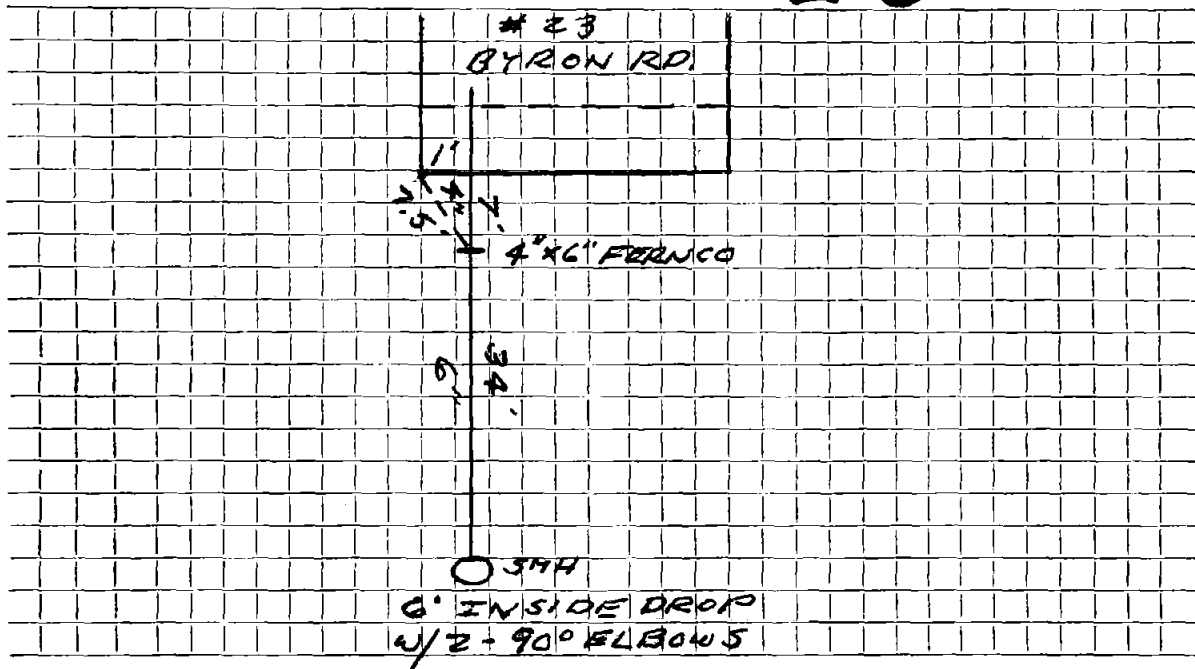

Connection made in BYRON RD. Street. Work completed .....

Remarks: CONNECTION MADE IN SMH .....