

Name Clifton H. Shorey

Service No. 104

Address 11 Calvin St.

Location

Lexington

Kind of Pipe

Size

Size of Main

~~Repair/ Renewal~~ - New Service

CON. 7-13-53

Location

Date	Material	Amount	Total	Date	Amount
6/8/53	Labor	41 60		6-1-53	Deposited 125
	10% overhead	4 16	45 76	7-13-53	Refund 40
	1/4'-6" Sewer Pipe @.342		15 05		84
	Joint Compound		2 64		
	4 Hr. Town Shovel @5.00		20 00		
	2 Hr. Trucking @.75		1 50		
			81 95		
				4/14/89	Respond + 100 amount B/H
	Labor				

TOWN OF LEXINGTON—DEPT. OF PUBLIC WORKS  
SEWER DIVISION

DATE.....

NO. ....

The undersigned applies for the construction of a particular sewer connecting No.....  
Street and hereby agrees to comply with the Rules and Regulations governing the construction and use of Particular  
sewers, as now or at any future time established by the Board of Selectmen.


Am't of estimate \$ . . . . .

Am't Paid \$ . . . . .

..... Owner

Sketch of Service Here **12**

S.W. For # 12

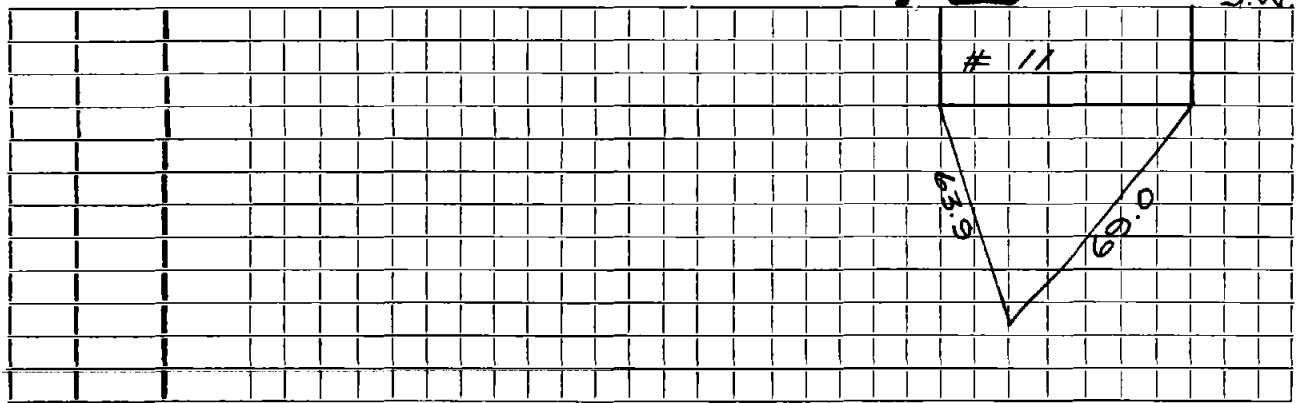

Connection made in . . . . . Street.

Work completed.....19..

Remarks: