

Name Ralph Boutell

Service No. 102

Address 16 Calvin St.

Location

Lexington

Kind of Pipe

Size

Size of Main

~~Repair~~ ~~Renewal~~ New Service

Con. 7-13-53

Location

Date	Material	Amount	Total	Date	Amount
6/3/53	Labor	41 60		6-1-53	Deposited 125 00
	10% overhead	4 16	45 76	7-13-53	Refunded 40 05
	4'-6" Sewer Pipe @.312		15 05		84 95
	Joint Compound		2 64		
	4 Hr. Town Shovel @5.00		20 00		
	2 Hr. Trucking		1 50		
			84 95		

Labor

TOWN OF LEXINGTON—DEPT. OF PUBLIC WORKS
SEWER DIVISION

DATE.....

NO.


The undersigned applies for the construction of a particular sewer connecting No.....
 Street and hereby agrees to comply with the Rules and Regulations governing the construction and use of Particular
 Sewers, as now or at any future time established by the Board of Selectmen.

Am't of estimate \$.....

Am't Paid \$.....

..... Owner

Sketch of Service Here

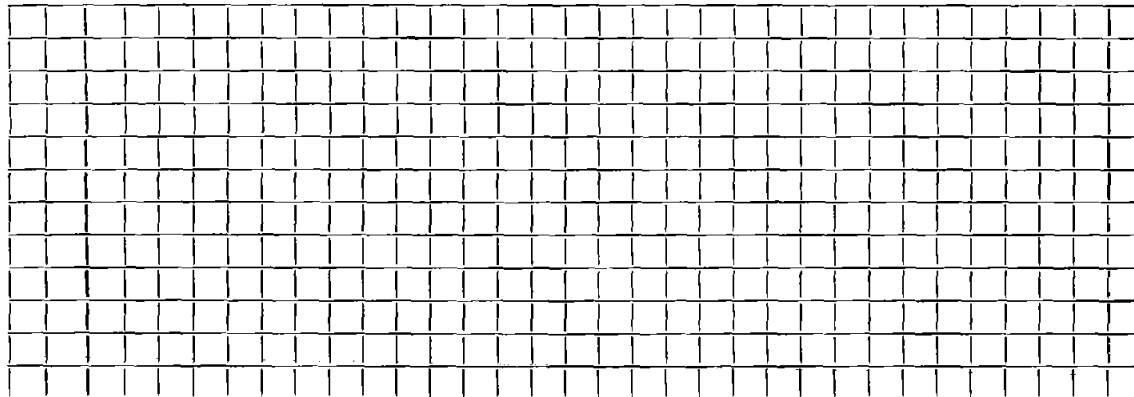

Connection made in..... Street.

Work completed.....19..

Remarks: