


DATE 9-29-94

TOWN OF LEXINGTON — BOARD OF PUBLIC WORKS
SEWER DIVISION

Sketch of Service Here **25**

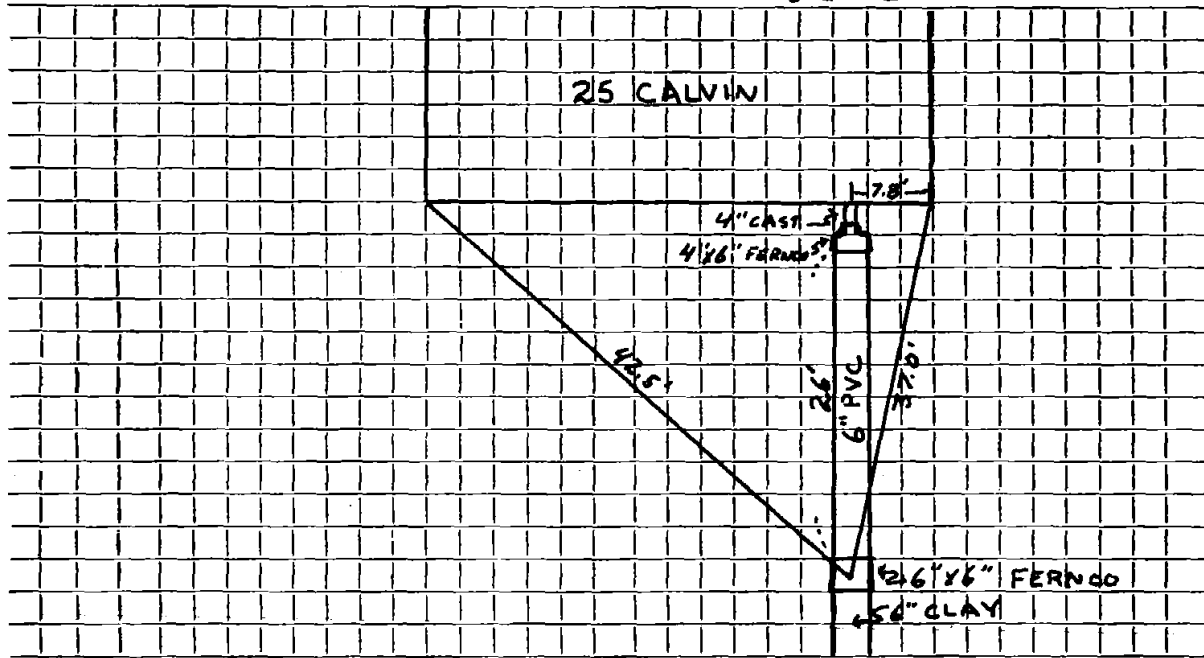

Connection made in CALVIN Street. Work completed

Remarks: