




DATE ~~12/18/18~~  
8/2017

TOWN OF LEXINGTON — BOARD OF PUBLIC WORKS

SEWER DIVISION

Sketch of Service Here

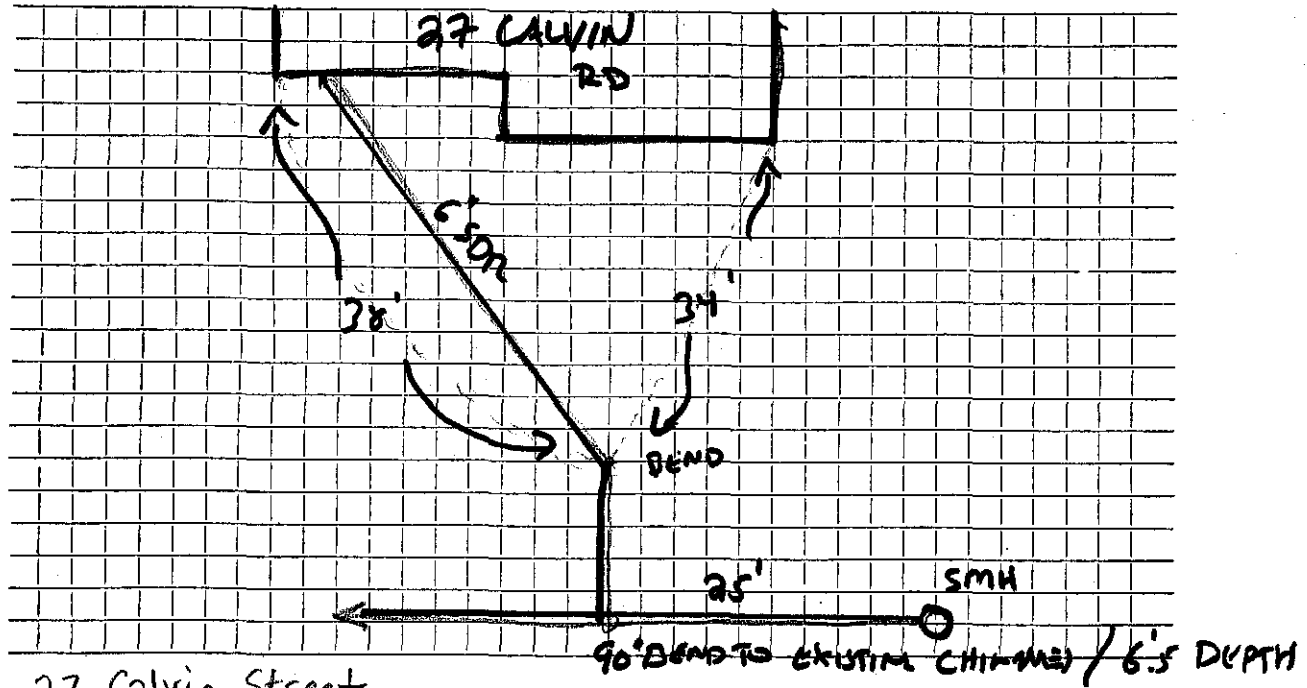

Connection made in 27 Calvin Street Street.

Work completed .....

Remarks: .....

MCLAUGHLIN