

Name Rose DiFranco

Service No. 214

Address 28 Calvin Street

Location

Kind of Pipe

Size

Size of Main

~~Repair~~ ~~Renewal~~ New Service CON. 12-31-53

Location

Date	Material	Amount	Total	Date	Amount
12/31/53	Labor	79.70		12-22-53	Deposited 125.00
	10' overhead	7.97	87.67	12-31-53	Refunded (4.33)
	50' - 6" sewer pipe	3.37	18.50		120.67
	joint compound		3.00		
	2 hrs. town shovel	5.00	10.00		
	2 hrs. trucking	.75	1.50	1-4-64	S.B. 34.44
5-1-64	Repair		120.67	1-5-64	S.B. 89.06
	16' 6" Transite				
	1 Duplex Adapter				
	Labor				
				12/13/66	Roots 667
				10/26/68	Roots 2-27-77. Roots at 16'
				12/23/68	Roots
				2/9/77	Roots 18' + 24' out

TOWN OF LEXINGTON—DEPT. OF PUBLIC WORKS
SEWER DIVISION

DATE

NO.


The undersigned applies for the construction of a particular sewer connecting No.
 Street and hereby agrees to comply with the Rules and Regulations governing the construction and use of Particular
 Sewers, as now or at any future time established by the Board of Selectmen.

Am't of estimate \$.....

Am't Paid \$.....

..... Owner

Sketch of Service Here **28**

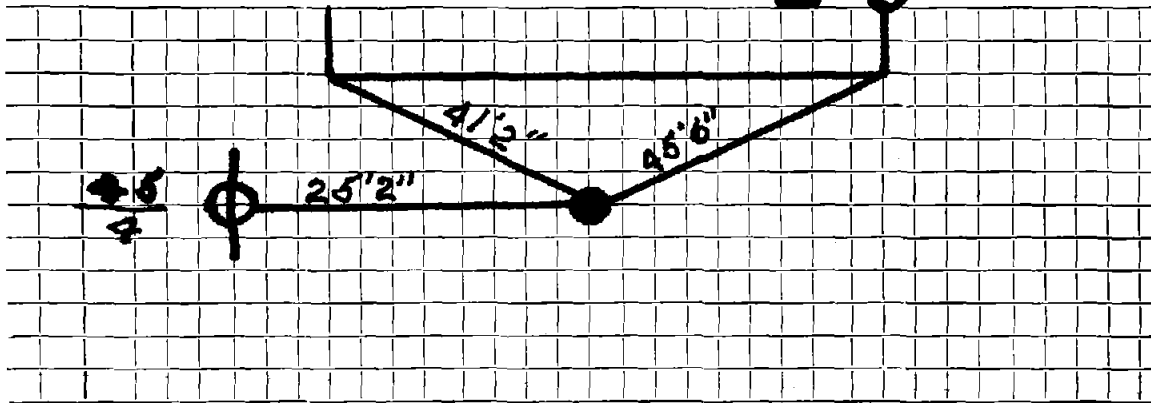

Connection made in Street.

Work completed 19..

Remarks:

