

Name

Service No.

Address 29 Calvin ST

Location

Kind of Pipe

Size

Size of Main

Repair—Renewal—New Service

Location

Date

Material

Amount

Total

Date

Amount

Outside

7-21-92

20'-6" PVC Pipe

7'-8" PVC Pipe

1-8x8x6 Tee

1-6" - 22° Bend

1-6" CI-PVC Furnce


1-6" PVC-PVC Furnce

2-8" CI-PVC Furnces

DATE \_\_\_\_\_

TOWN OF LEXINGTON — BOARD OF PUBLIC WORKS  
SEWER DIVISION

Sketch of Service Here **29**

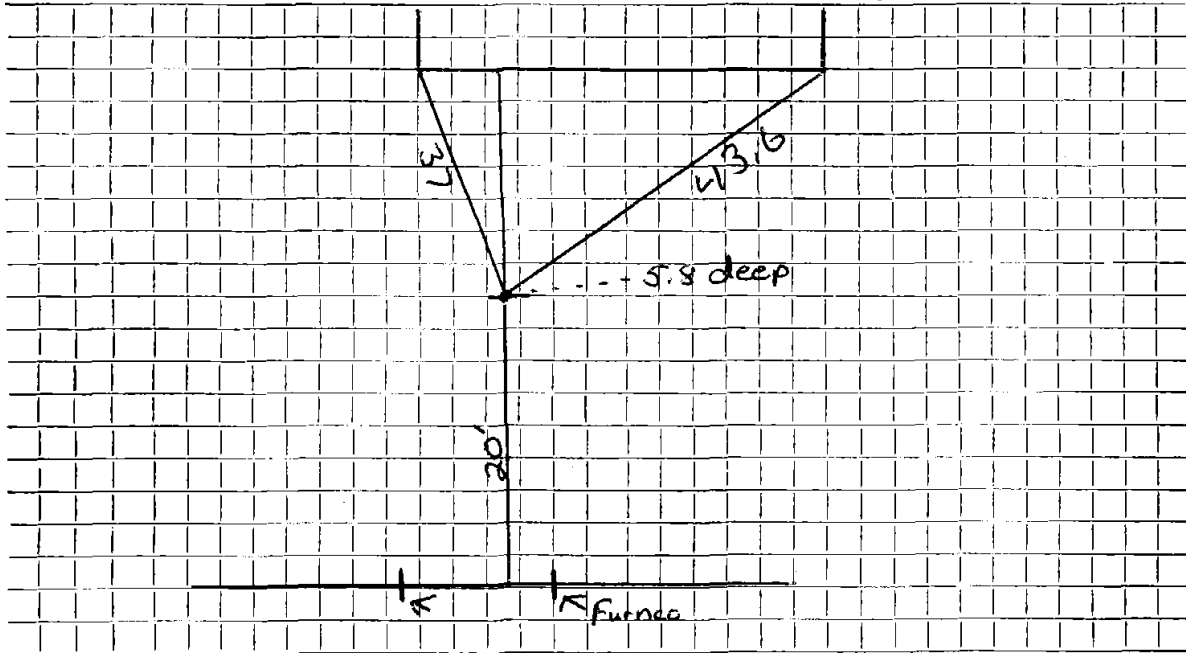

Connection made in .. 7-21-92 ..... Street. Work completed .....

Remarks: .....  
.....  
.....